



April 17<sup>th</sup>, 2025

Hocutt-Ellington Library Renovation

Bid # 700-ENG-2025-12

Addendum No. 02

**Please note that this addendum is for changes and/or clarifications to the Bid Documents.**

### **Bid Changes**

Bidders on this Project are hereby notified that this Addendum as all other Addenda shall be attached to and made a part of the above-named Bidding and Contract Documents.

The following items are issued to add to, modify, and/or clarify the Bidding and Contract Documents. These items shall have full force and effect as the Bidding and Contract Documents and costs involved shall be included in the bid prices. Bids to be submitted on the specified bid date shall conform to the additions and revisions listed herein.

---

The date of issuance of this addendum is 4/17/2025. All conditions of the addendum are in effect as of this date. Bidders are hereby informed that the following additions, deletions, changes and/or clarifications supersede and supplement the Contract Documents for the above referenced project.

Each bidder shall be responsible for notifying his subcontractors and/or vendors of the contents of this Addendum. The items included in this Addendum are for all Contractors as the items relate to their respective trades.

---

|                        |                                      |
|------------------------|--------------------------------------|
| From:                  | Davis Kane Architects, PA            |
| Transmitted to:        | Plan Rooms; Known Interested Bidders |
| Total Number of Pages: | 13                                   |

### **RFI's:**

1. Per RFI#6 answer, they want metal cove trim in lieu of cove base. However, the Dilex-HKS has 2 anchoring sides so that can be used where wall tile meets the floor tile, but cannot be used at areas with no wall tile. Did they want wall tile throughout the room (elevations G4+G6 on A400 only indicate wet wall) – Otherwise, we will have to use the floor tile bullnose as the trim for the non-tile walls.
  - a. **A revised detail for the walls not receiving tile has been developed. Refer to detail A6 on revised sheet A610.**
2. I was looking through addendum #1 and noticed they removed the tile base & replaced with Schluter Dilex. I am not understanding this since only the wet wall is getting wall tile according to sheet A400. Does this mean they are adding wall tile to all walls? You only use Schluter Dilex where floor & wall tile meet. Please advise if I should add wall tile to all walls or add tile base to walls not receiving wall tile.
  - a. **Only the wet walls that are elevated on sheet A400 will receive full height wall tile. A new detail clarifying the non-tiled restroom walls has been added. Refer to detail A6/A610 and revised elevations on sheet A400.**
3. On sheet I-100 a sign type "ST-F" on D1/I100, but it is not detailed on the signage plan or drawing. Can you clarify what this sign is and its dimensions?
  - a. **This was leftover from a previous sign type that is no longer within the project. This has been removed, refer to revised Sheet I100.**
4. 033000 1.7.A All installers and supervisors to be ACI Technician certified. This is mostly just a remove and pour back. Are these certifications needed?
  - a. **ACI certification is not required for this project.**
5. 051200 requires steel fabricator & erector to be AISC certified. For this small of a job can this requirement be deleted?
  - a. **AISC certification is not required for this project.**
6. Article 2 found in the bid form documents says to include a certificate of authorization to do business in North Carolina (Secretary of State). Can you please provide clarification on the following: According to the NC Secretary of State's website, a Certificate of Authorization to do business in NC is for foreign entities. A Certificate of Existence is proof of registration for NC companies to do business in NC and that the company is in good standing with the SOS. Which form is needed for the Hocutt-Ellington Library Renovation bid?
  - a. **The "Certificate of Existence" is the document that shall be used for this project. The other form can be disregarded.**

### **General Clarifications:**

1. **Clarification: Regarding the fire alarm scope, the Owner will have the existing system removed prior to the GC taking over the library for renovation. The**

electrical drawings have been updated to communicate that the Owner will remove the existing fire alarm system before the GC takes over the building.

2. **Clarification: Regarding access controls, intrusion alarm, and security camera scope, all of the infrastructure for these scope items shall be in the GC's scope of work. But the new access controls, alarm, and security cameras, associated wiring, devices, face plates, etc. will be installed by the Owner's 3<sup>rd</sup> party vendor and the GC shall coordinate with them as part of their scheduling of construction activities. The electrical drawings and specs have been updated to communicate this intent for the GC to provide just the infrastructure.**
3. **Last day to ask questions and request clarifications is Fri Apr 18 at 5PM. No questions submitted after this time will be answered out of fairness to all bidders.**
4. **A final addendum (Addendum 3) will be sent out on Tue Apr 22 and it will include responses to any questions not yet addressed and any additional questions received up until Apr 18 at 5PM.**

**Specifications:**

1. (None)

**Drawings:**

1. Sheet A400
  - a. Revised Restroom Elevations G4, G6, and A2 to remove the bullnose tile base (TB1) and instead indicate a metal transition trim.
2. Sheet A610
  - a. Added detail A6 to indicate the floor base treatment in restrooms for walls that do not have tile.
3. Sheet I100
  - a. Removed signage tag "ST-F" from the children's room area.
4. Sheet ED201
  - a. Clarifications for fire alarm system scope.
5. Sheet E201
  - a. Clarifications for access control, intrusion alarm and security panels, devices, and wiring.
6. Sheet E202
  - a. Clarifications for access control, intrusion alarm and security panels, devices, and wiring.

**Attachments:**

1. Current Bidder's List
2. Sheet A400
3. Sheet A610
4. Sheet I100
5. Sheet ED201
6. Sheet E201

## 7. Sheet E202

This addendum has been acknowledged and signed by an authorized representative of the firm and must be returned with your bid. **Failure to do so will cause your bid to be rejected:**

By: \_\_\_\_\_

(Signature)

Name: \_\_\_\_\_

(Printed)

Title: \_\_\_\_\_

Date \_\_\_\_\_

# BID REGISTER



**DAVIS KANE**  
ARCHITECTS, PA  
503 Oberlin Road | Suite 300  
Raleigh, NC 27605 | 919.833.3737

Project Contact: Chad Volk

Email: cvolk@daviskane.com

|                             |   |
|-----------------------------|---|
| Project:                    | Hocutt-Ellington Library Renovation   |
| Owner:                      | Town of Clayton   |
| Owner ID No:                | 700-ENG-2025-12   |
| DKA Project No:             | 2415  |
| Bid Due Date & Time:        | 04/29/25 at 2:00 pm   |
| Bid Receiving Location:     | Town of Clayton Town Hall located at 111 E. Second St. Clayton, NC 27520      |
| PreBid Mtg Date & Location: | 04/08/25 at 10:00am at Clayton Town Hall, 111 E. Second St. Clayton, NC 27520 |


BID TYPE: \_\_\_\_\_ INVITED \_\_\_\_\_ PREQUALIFICATION \_\_\_\_\_ X OPEN

ADDENDA DATES: 1. 4/10/25 2. 4/17/25 3. \_\_\_\_\_ 4. \_\_\_\_\_ 5. \_\_\_\_\_


| ADDENDA: |   |   |   |   | RECIPIENT   | REC'D BID DOCUMENTS VIA? |                    | BIDDING AS A GC? | ATTENDED PREBID? |
|----------|---|---|---|---|---|--------------------------|--------------------|------------------|------------------|
| 1        | 2 | 3 | 4 | 5 |   |                          |                    |                  |                  |
| X        | X | X | X | X |   |                          |                    |                  |                  |
|          |   |   |   |   | Company Name<br>Company Address<br>Contact Name<br>PH: XXX-XXX-XXXX EMAIL: XXXXXXXXXXXX@XXXXXX.COM  | Y/N                      | EMAIL / SHARE FILE | Y/N              | Y/N              |
| X        |   |   |   |   | Maybridge Development<br><br>Mark Santos<br>910-551-9498 <a href="mailto:mark@maybridge.com">mark@maybridge.com</a>   | Y                        |                    | Y                | N                |
| X        |   |   |   |   | LLDC Inc.<br><br>David Locklear<br>910-485-6002 <a href="mailto:dl@lldrywall-construction.com">dl@lldrywall-construction.com</a>  | Y                        |                    | Y                | N                |
| X        |   |   |   |   | Diamond Contracting<br><br>Andy Wood; Bryan Wolfe <a href="mailto:byran@diamondcontracting.com">byran@diamondcontracting.com</a><br>919-868-1955 <a href="mailto:andy@diamondcontracting.com">andy@diamondcontracting.com</a> | Y                        |                    | Y                | Y                |
| X        |   |   |   |   | Vortex Construction Co., LLC<br><br><a href="mailto:tking@vortexconstruction.net">Tracey King, Lee King</a><br>9198682450 <a href="mailto:tking@vortexconstruction.net">tking@vortexconstruction.net</a>                      | Y                        |                    | Y                | Y                |
| X        |   |   |   |   | Riggs-Harrod Builders, Inc.<br><br><a href="mailto:tcothran@riggsharrod.com">Tim Cothran</a><br>919-687-0111 <a href="mailto:tcothran@riggsharrod.com">tcothran@riggsharrod.com</a>   | Y                        |                    | Y                | Y                |
| X        |   |   |   |   | Berry Building Group, Inc<br><br><a href="mailto:jasonk@berrybg.com">Jason Knoernschild, Jesse Wells</a><br>9198104120 <a href="mailto:jasonk@berrybg.com">jasonk@berrybg.com</a>   | Y                        |                    | Y                | Y                |

|   |  |  |  |  |   |  |   |   |
|---|--|--|--|--|---|--|---|---|
| X |  |  |  | Dewberry Design-Builders Inc.<br><a href="#">Alysen Marie Nassif, Rick Jones</a><br>9194243772 anassif@dewberry.com  | Y |  | Y | Y |
| X |  |  |  | Shepherd Response LLC<br><a href="#">Sambau Ly; Rob Mallard</a><br>9196029582 sam@shepherd-response.com              | Y |  | Y | Y |
| X |  |  |  | R.L. Pullen & Associates, Inc.<br><a href="#">Daniel Pullen</a><br>919-247-2663 daniel@rlpullen.com                  | Y |  | Y | N |
| X |  |  |  | Salisbury & Moore Construction<br><a href="#">Gus Mixon; Kyle Annlock</a><br>9197301238 gus.mixon@salisburymoore.com | Y |  | Y | Y |
| X |  |  |  | ACH Constructors, LLC<br><a href="#">Mark Ferris</a><br>919-484-9550 MarkF@ACHConstructors.com                       | Y |  | Y | Y |
| X |  |  |  | JD Beam<br><a href="#">Tim Manning</a><br>919-755-7560 timm@jdbeam.com   | Y |  | Y | N |
| X |  |  |  | 35 North<br><a href="#">Mike Lutz</a><br>2526220668 mlutz@35n.com  | Y |  | Y | Y |
| X |  |  |  | Muter Construction<br><a href="#">Jake Bowman</a><br>9193751135 jbowman@muterconstruction.com                        | Y |  | Y | N |
| X |  |  |  | Focus Design Builders<br><a href="#">John Graham</a><br>9198166422 jgraham@focusdesignbuilders.com                   | Y |  | Y | N |
| X |  |  |  | Brookwood Construction<br><a href="#">Patrick Bur; Tabb Connor</a><br>3015032737 patrick@brookwood-construction.com  | Y |  | Y | Y |
| X |  |  |  | CATE Services and Construction<br><a href="#">Gabriel Henry</a><br>9105272552 ghenry@catesvc.com                     | Y |  | Y | Y |
| X |  |  |  | DSW Homes, LLC<br><a href="#">Devon Littlefield</a><br>4097443400 devon.littlefield@dswhomes.com                     | Y |  | Y | N |
| X |  |  |  | Plank Construction<br><a href="#">Sany Bezerra</a><br>252-341-3637 operations@plank-construction.com                 | Y |  | Y | N |
| X |  |  |  | Quality Builders Inc.<br><a href="#">Joel Raper</a><br>919.821.9001 joelr@qbiraileigh.com                            | Y |  | Y | N |


|   |  |  |  |   |   |  |   |   |
|---|--|--|--|---|---|--|---|---|
| X |  |  |  | The Innovative Contracting Group<br><a href="#">Karina Morel</a><br>743.255.2128 kmorel@icg-usa.com                                       | Y |  | Y | N |
| X |  |  |  | MLB Construction Services<br><a href="#">Denis Price; Shauna Raymond</a><br>919.387.4647 dprice@mlbind.com                                | Y |  | Y | N |
| X |  |  |  | CMC Building Inc<br><a href="#">Parin Bodiwala</a><br>919-321-5018 <a href="mailto:parin@cmcbuildinginc.com">parin@cmcbuildinginc.com</a> | Y |  | Y | N |

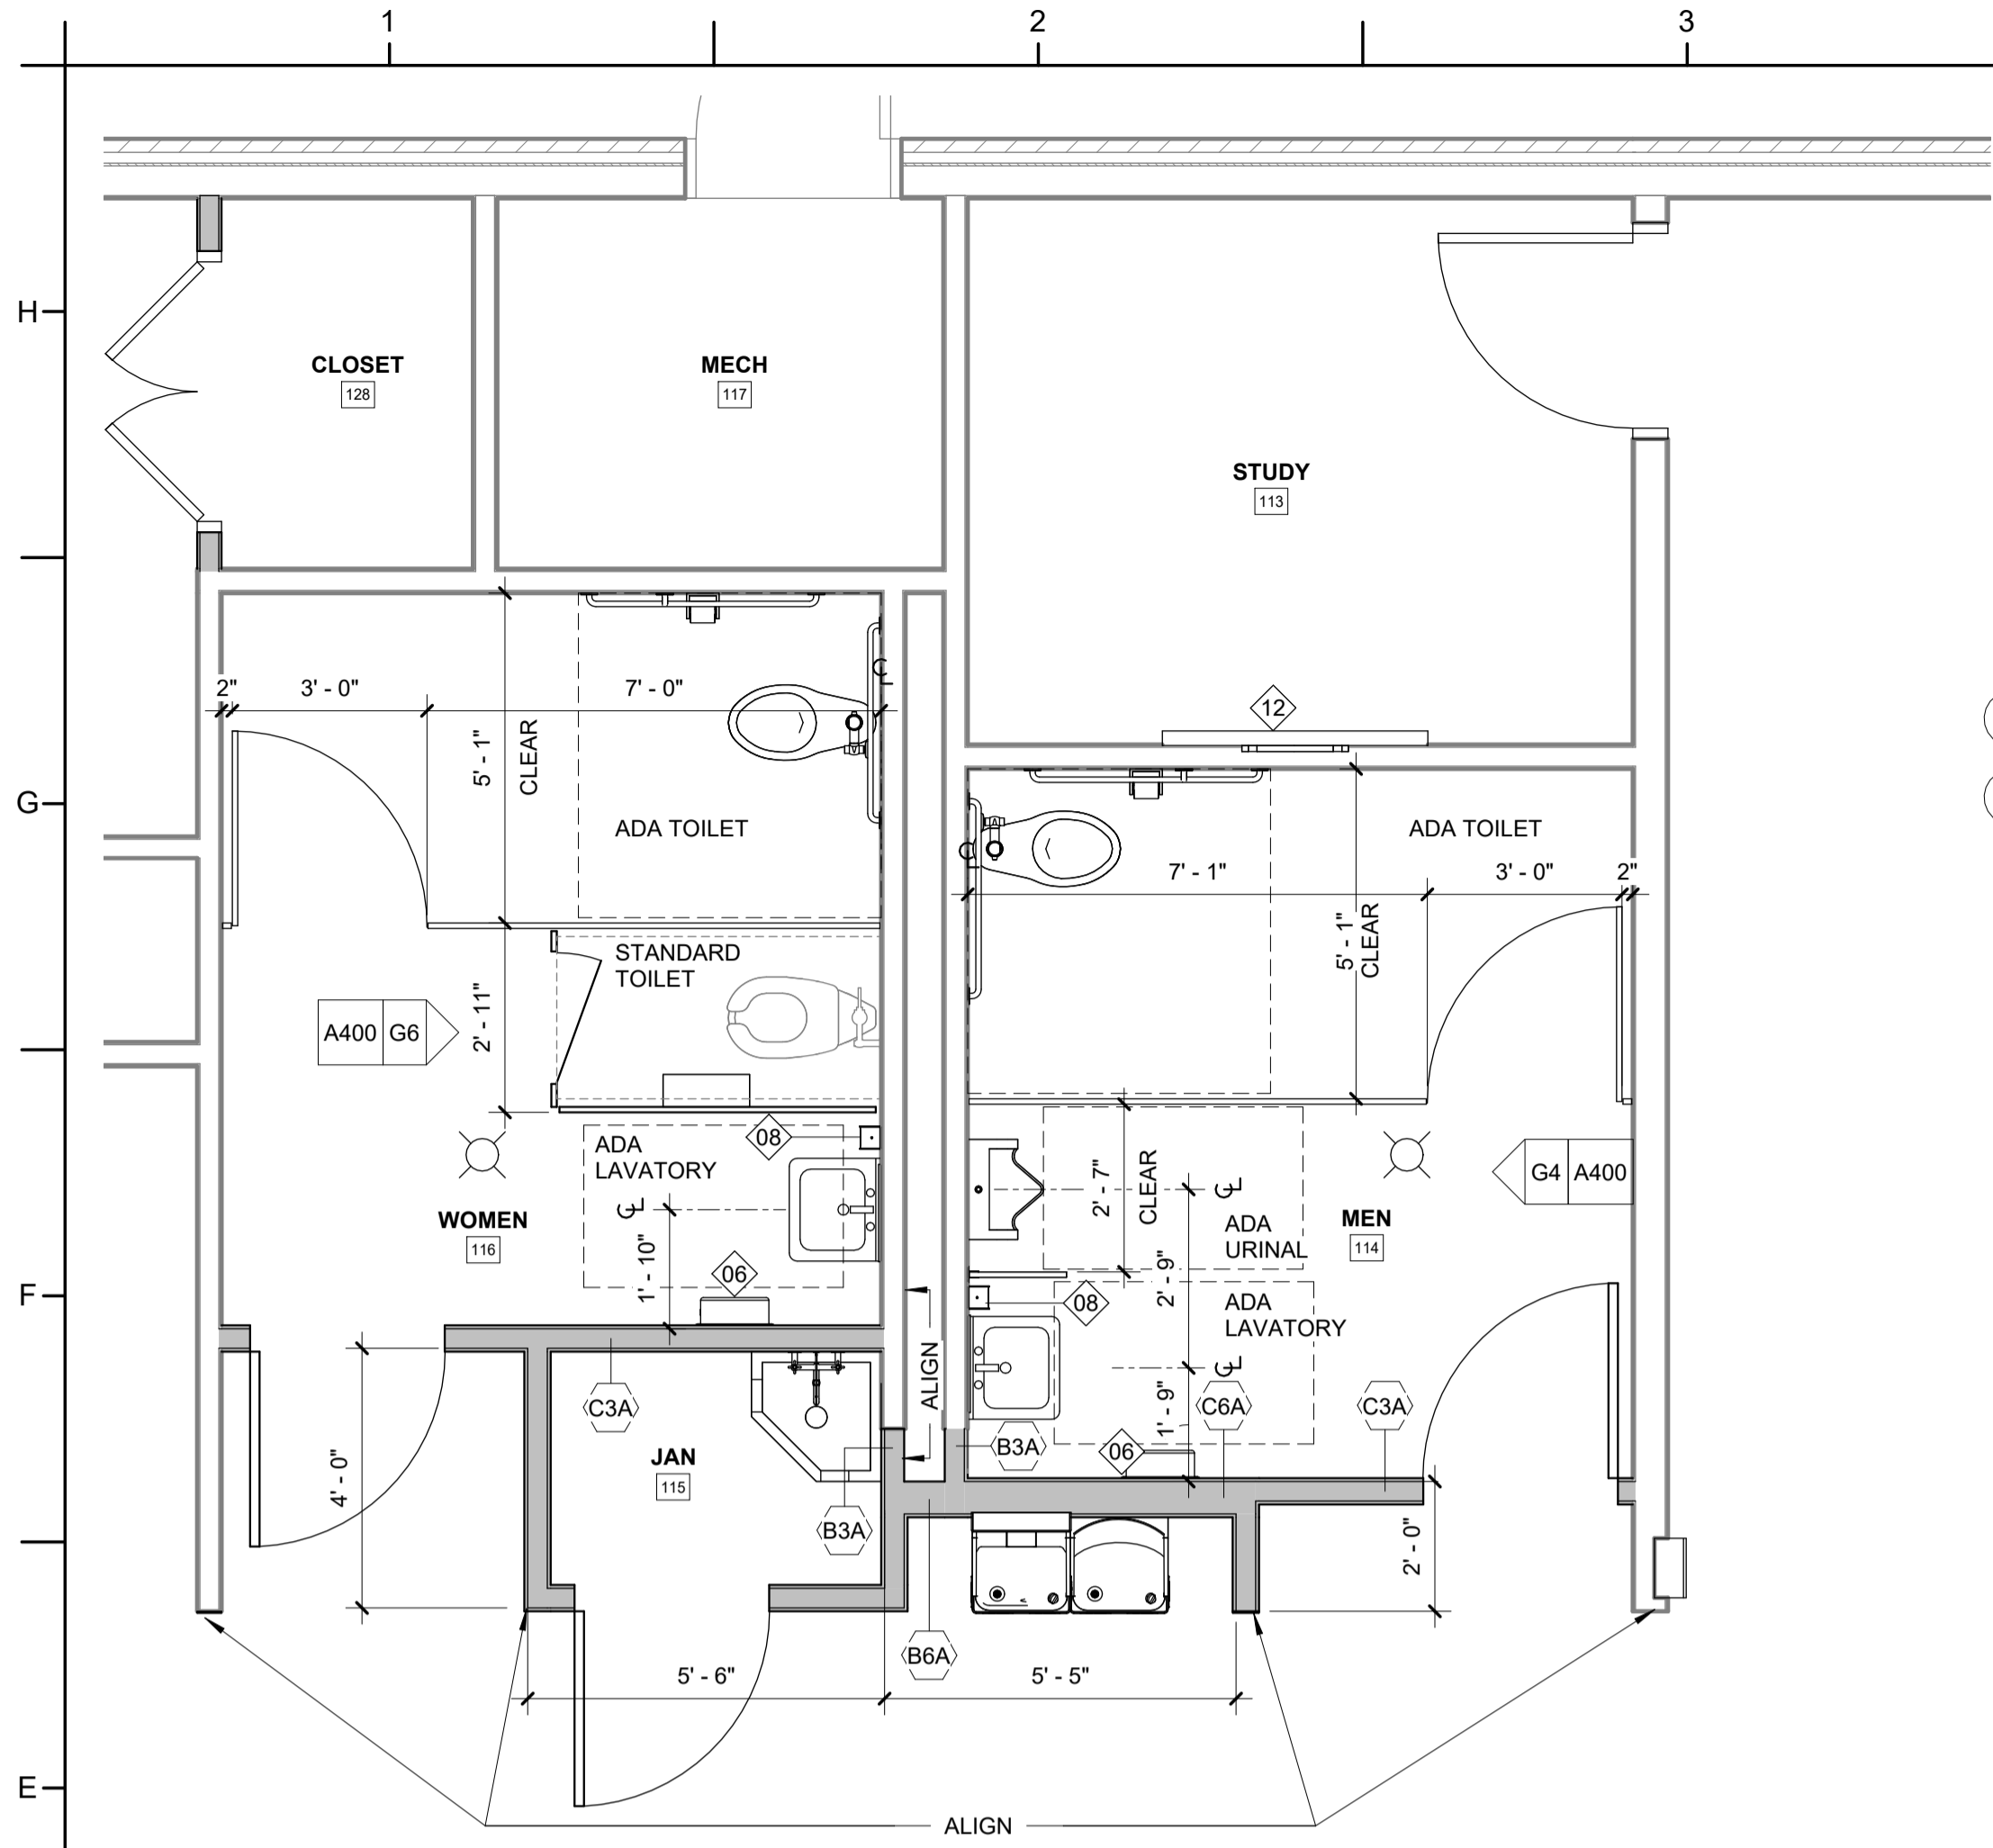


**C1** ENLARGED GROUP RESTROOM PLAN  
3/8" = 1'-0"

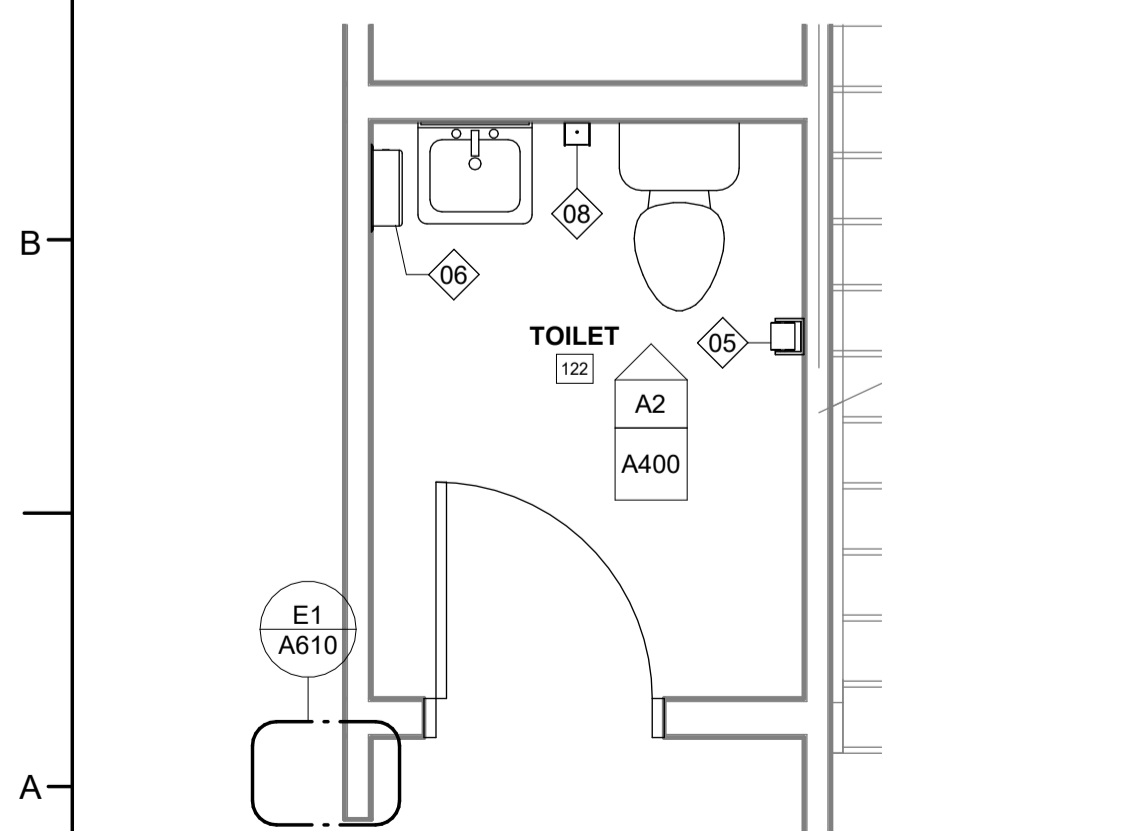


**A1** SINGLE RESTROOM PLAN  
3/8" = 1'-0"

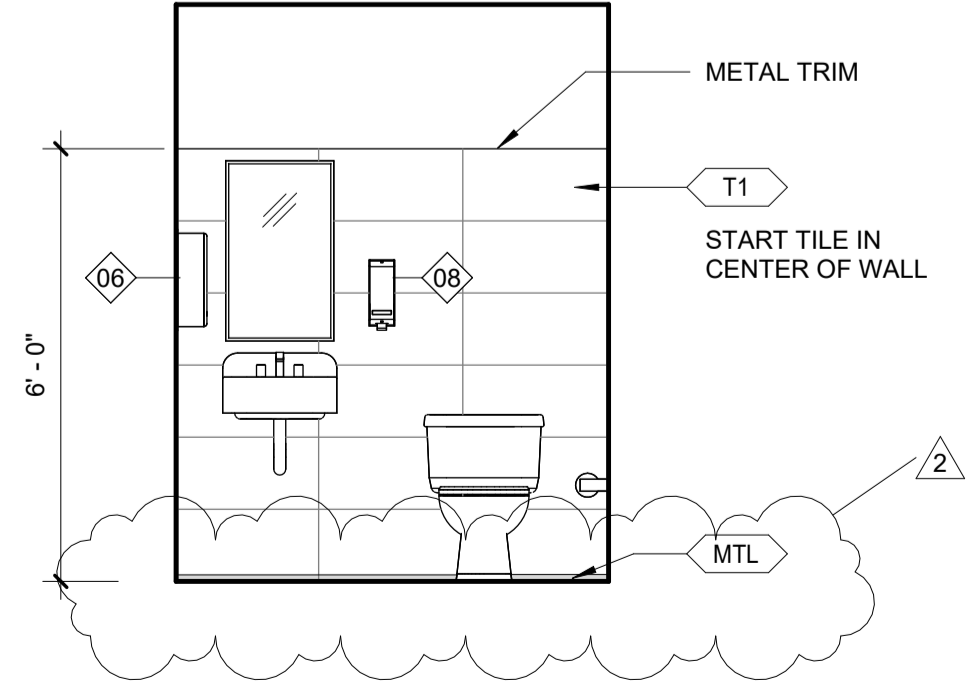

**A2** SINGLE RESTROOM ELEVATION  
3/8" = 1'-0"

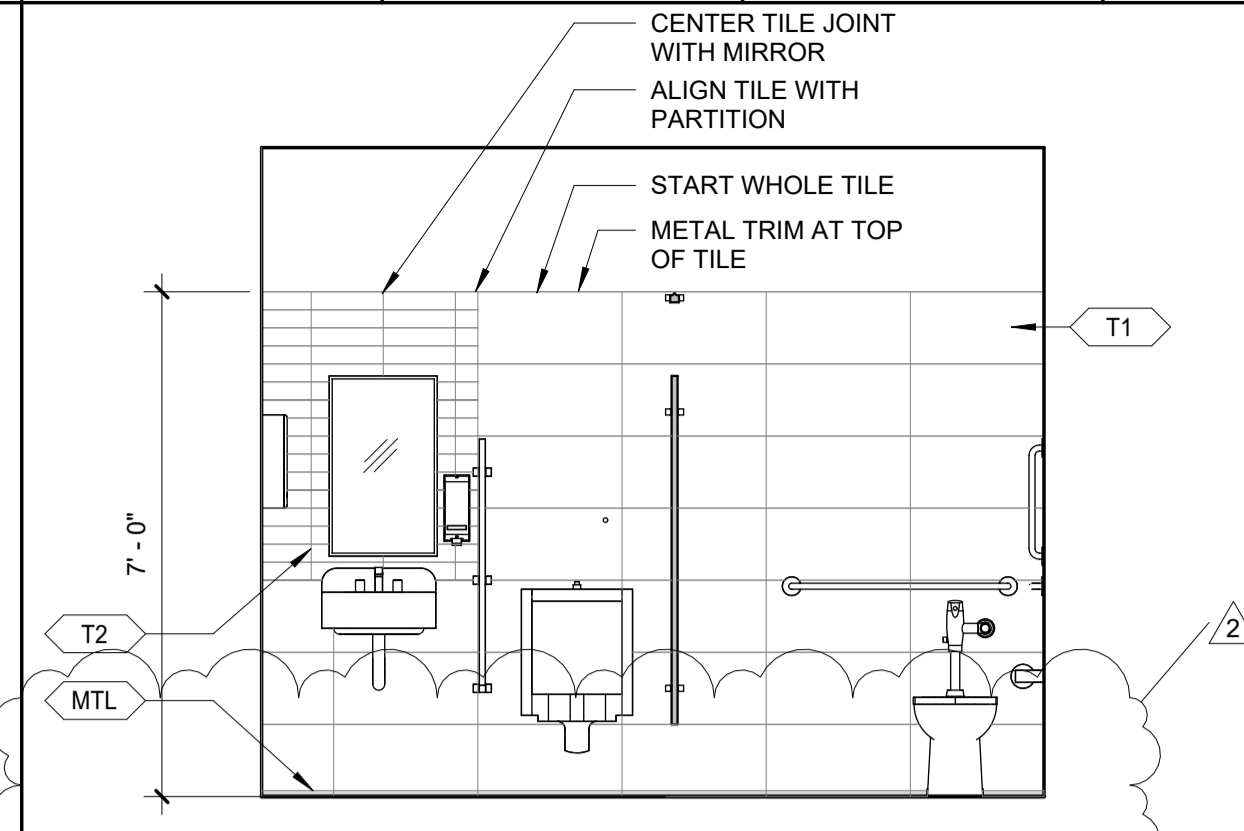


**G4** MEN'S RESTROOM ELEVATION  
3/8" = 1'-0"

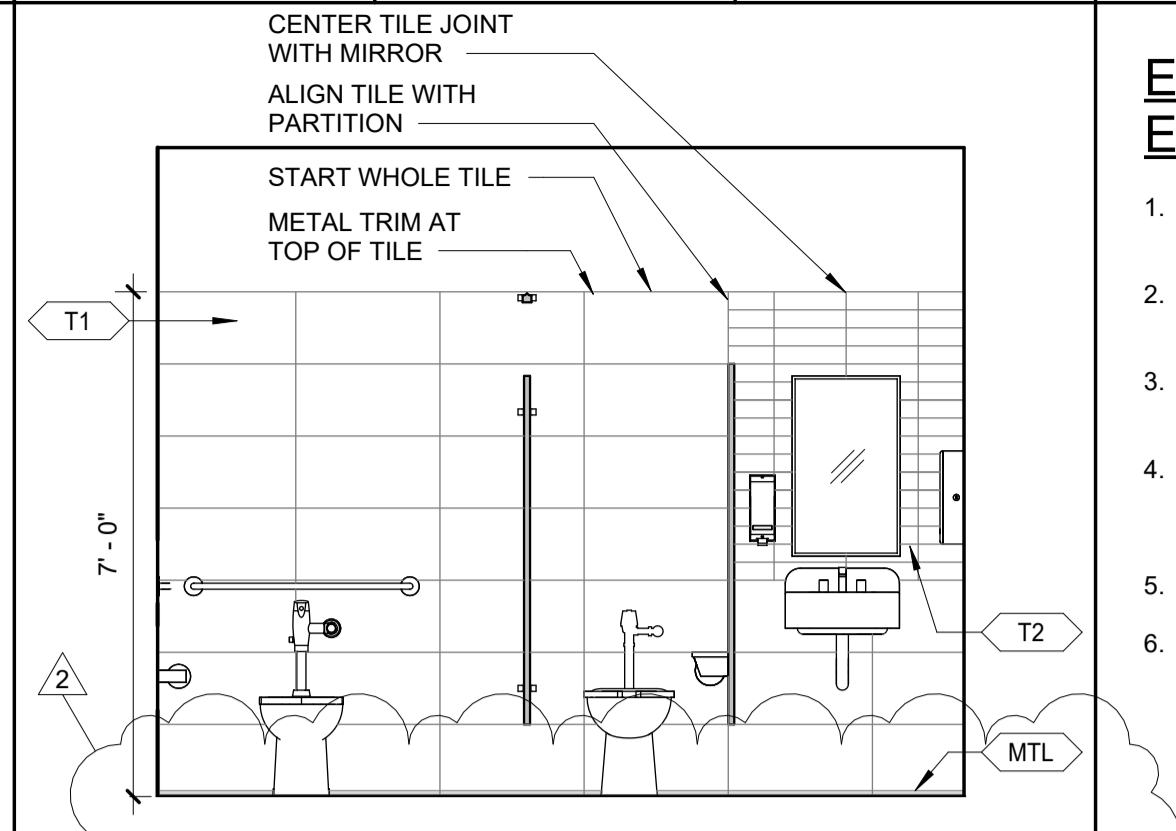


**G6** WOMEN'S RESTROOM ELEVATION  
3/8" = 1'-0"

**ENLARGED PLAN & INTERIOR ELEVATION GENERAL NOTES:**


1. SHELVES WIDER THAN 30" SHALL BE 1" THICK. NARROWER SHELVES SHALL BE 3/4" THICK, UON.
2. NUMBER OF SHELVES, DOORS, AND DRAWERS SHALL BE AS INDICATED ON INTERIOR ELEVATIONS.
3. LOCKABLE CABINETS ARE INDICATED WITH "L" ON INTERIOR ELEVATIONS.
4. ALL VOIDS CREATED BY VERTICAL FILLER PANELS AT TOP OF TALL CABINETS AND BOTTOM OF WALL CABINETS ARE TO BE FILLED WITH FILLER PANELS FINISHED TO MATCH ADJACENT SURFACES.
5. REFER TO MATERIAL LEGEND FOR FINISHES AND MATERIALS.
6. TYPICAL BASE AND WALL CABINETS DESIGNED IN 3" INCREMENTS ARE INTENDED TO BE PREFABRICATED MODULAR CABINETS. UNLESS NOTED OTHERWISE, ATYPICAL CABINET SIZES OR DESIGNS ARE INTENDED TO BE CUSTOM CABINETRY, UNLESS NOTED OTHERWISE. COORDINATE WITH SPECIFICATIONS TO CONFIRM.

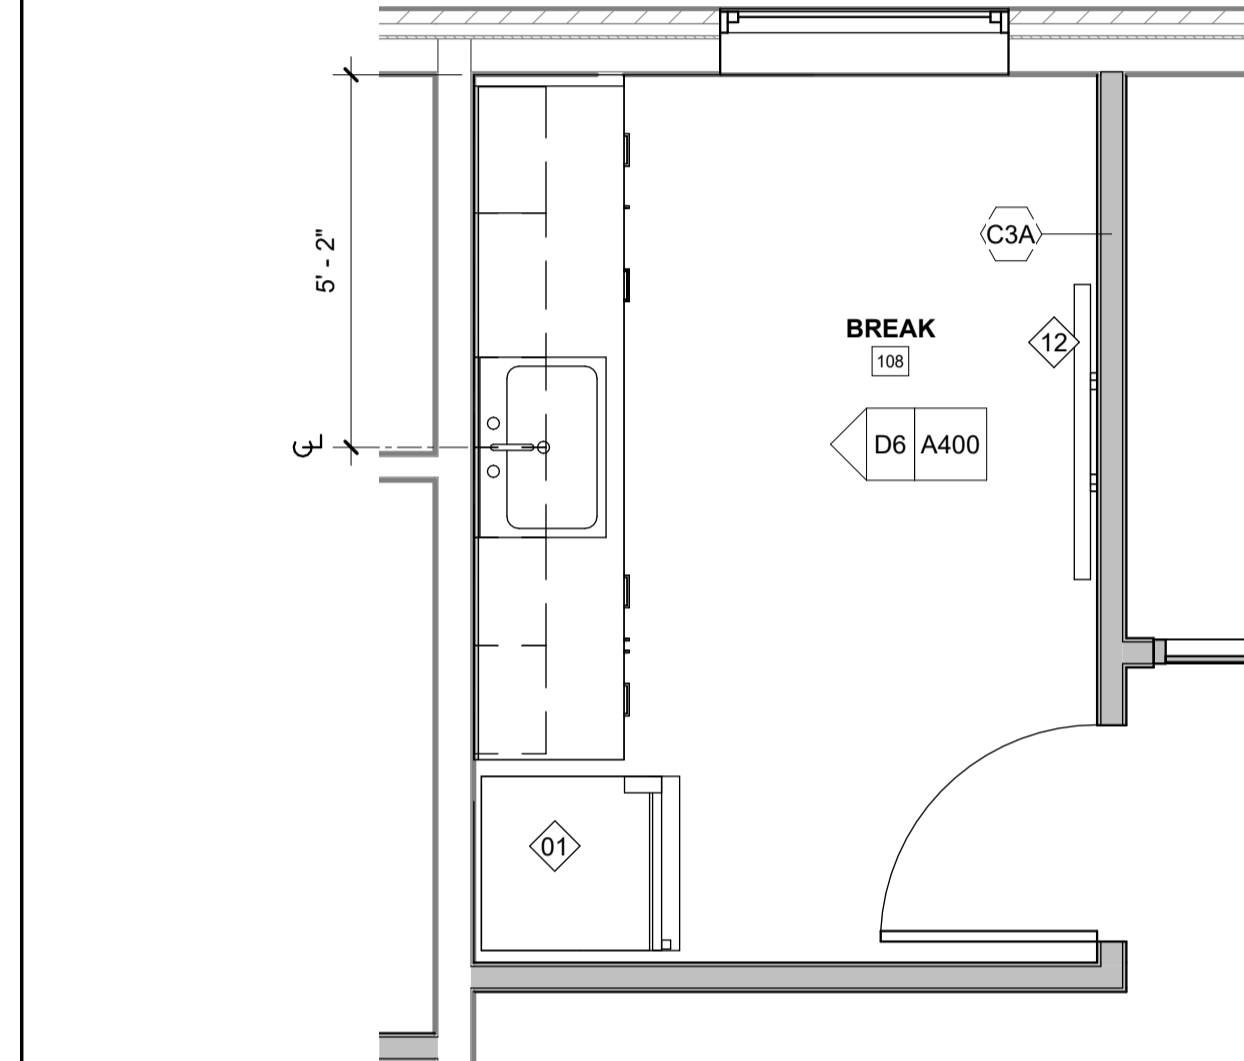

**D4** ENLARGED PLAN - BREAK ROOM  
3/8" = 1'-0"

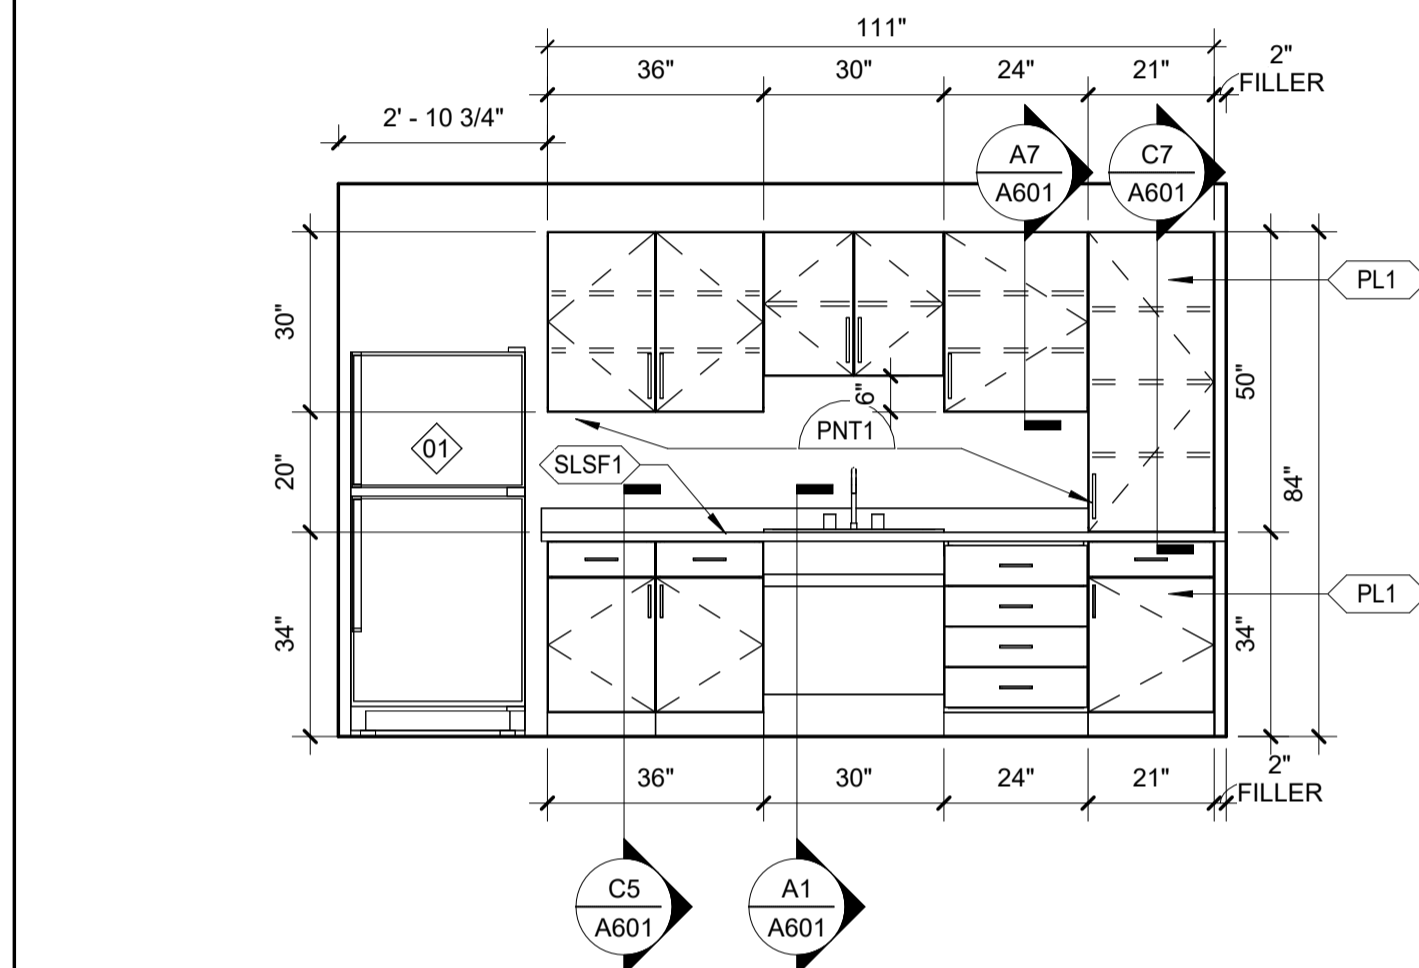

**D6** INTERIOR ELEVATION - BREAK ROOM  
3/8" = 1'-0"

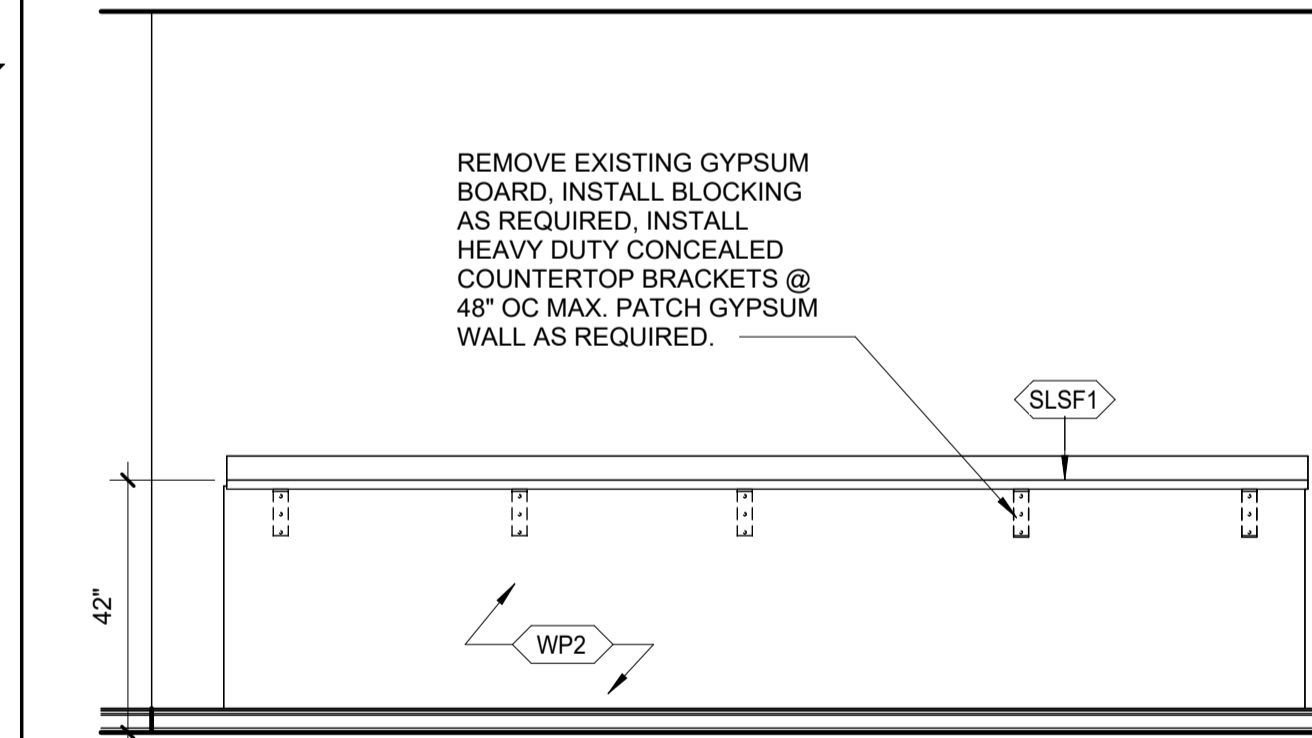

**B4** LAPTOP COUNTER ELEVATION  
3/8" = 1'-0"

**PROJECT INFORMATION**

**HOCUTT-ELLINGTON**  
**LIBRARY RENOVATION**  
TOWN OF CLAYTON  
100 CHURCH ST.  
CLAYTON, NC 27520

**SEALS**



**DKA JOB NUMBER**

2415

**REVISIONS**

2 ADD 2 04/17/25

These drawings are the property of Davis Kane Architects, P.A. They may not be used for any purpose without written permission.  
Copyright © 2024 by Davis Kane Architects, P.A.  
All rights reserved.

PA: JIMMY ARDEL EDWARDS  
PM: CV  
Drawn By: BG  
Plot Date: 4/15/2025 4:25:03 PM

**DATE ISSUED**









BID DOCUMENTS

03/10/2025

**SHEET TITLE**

ENLARGED PLANS & INT ELEVATIONS

**A400**

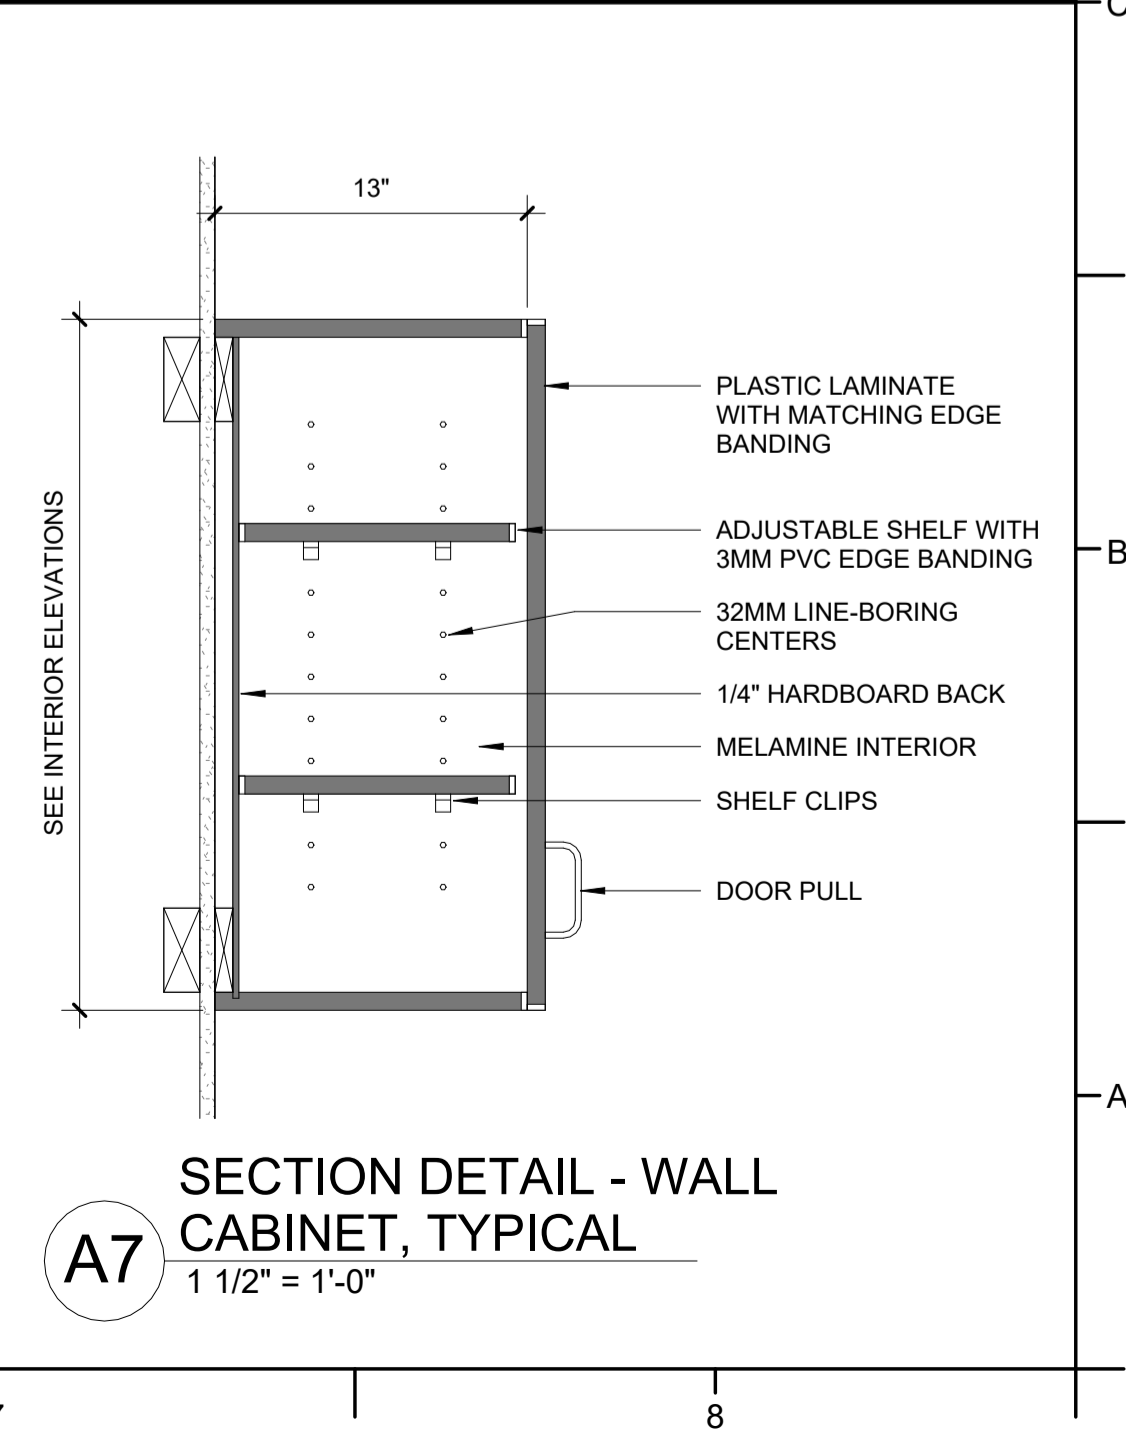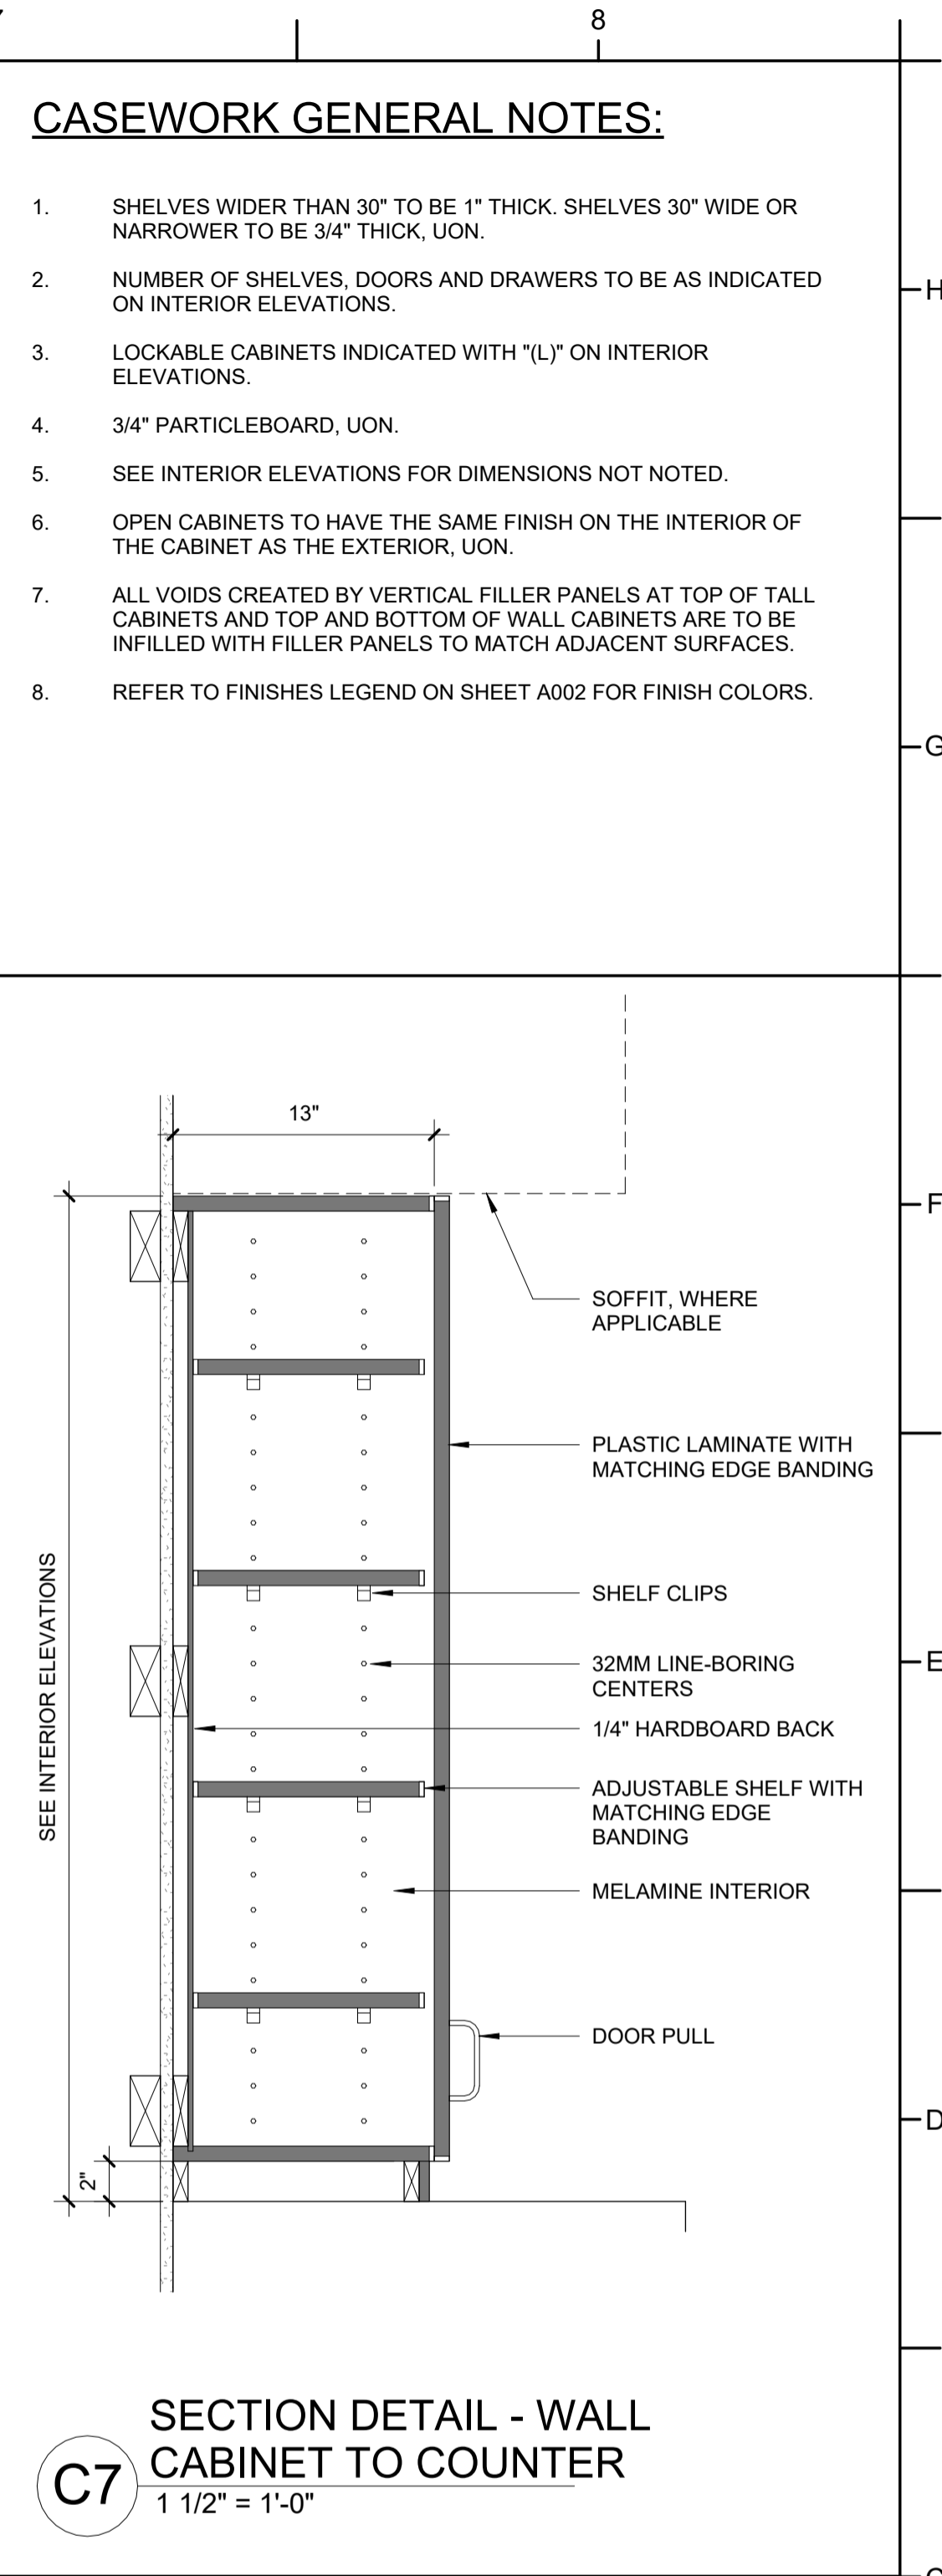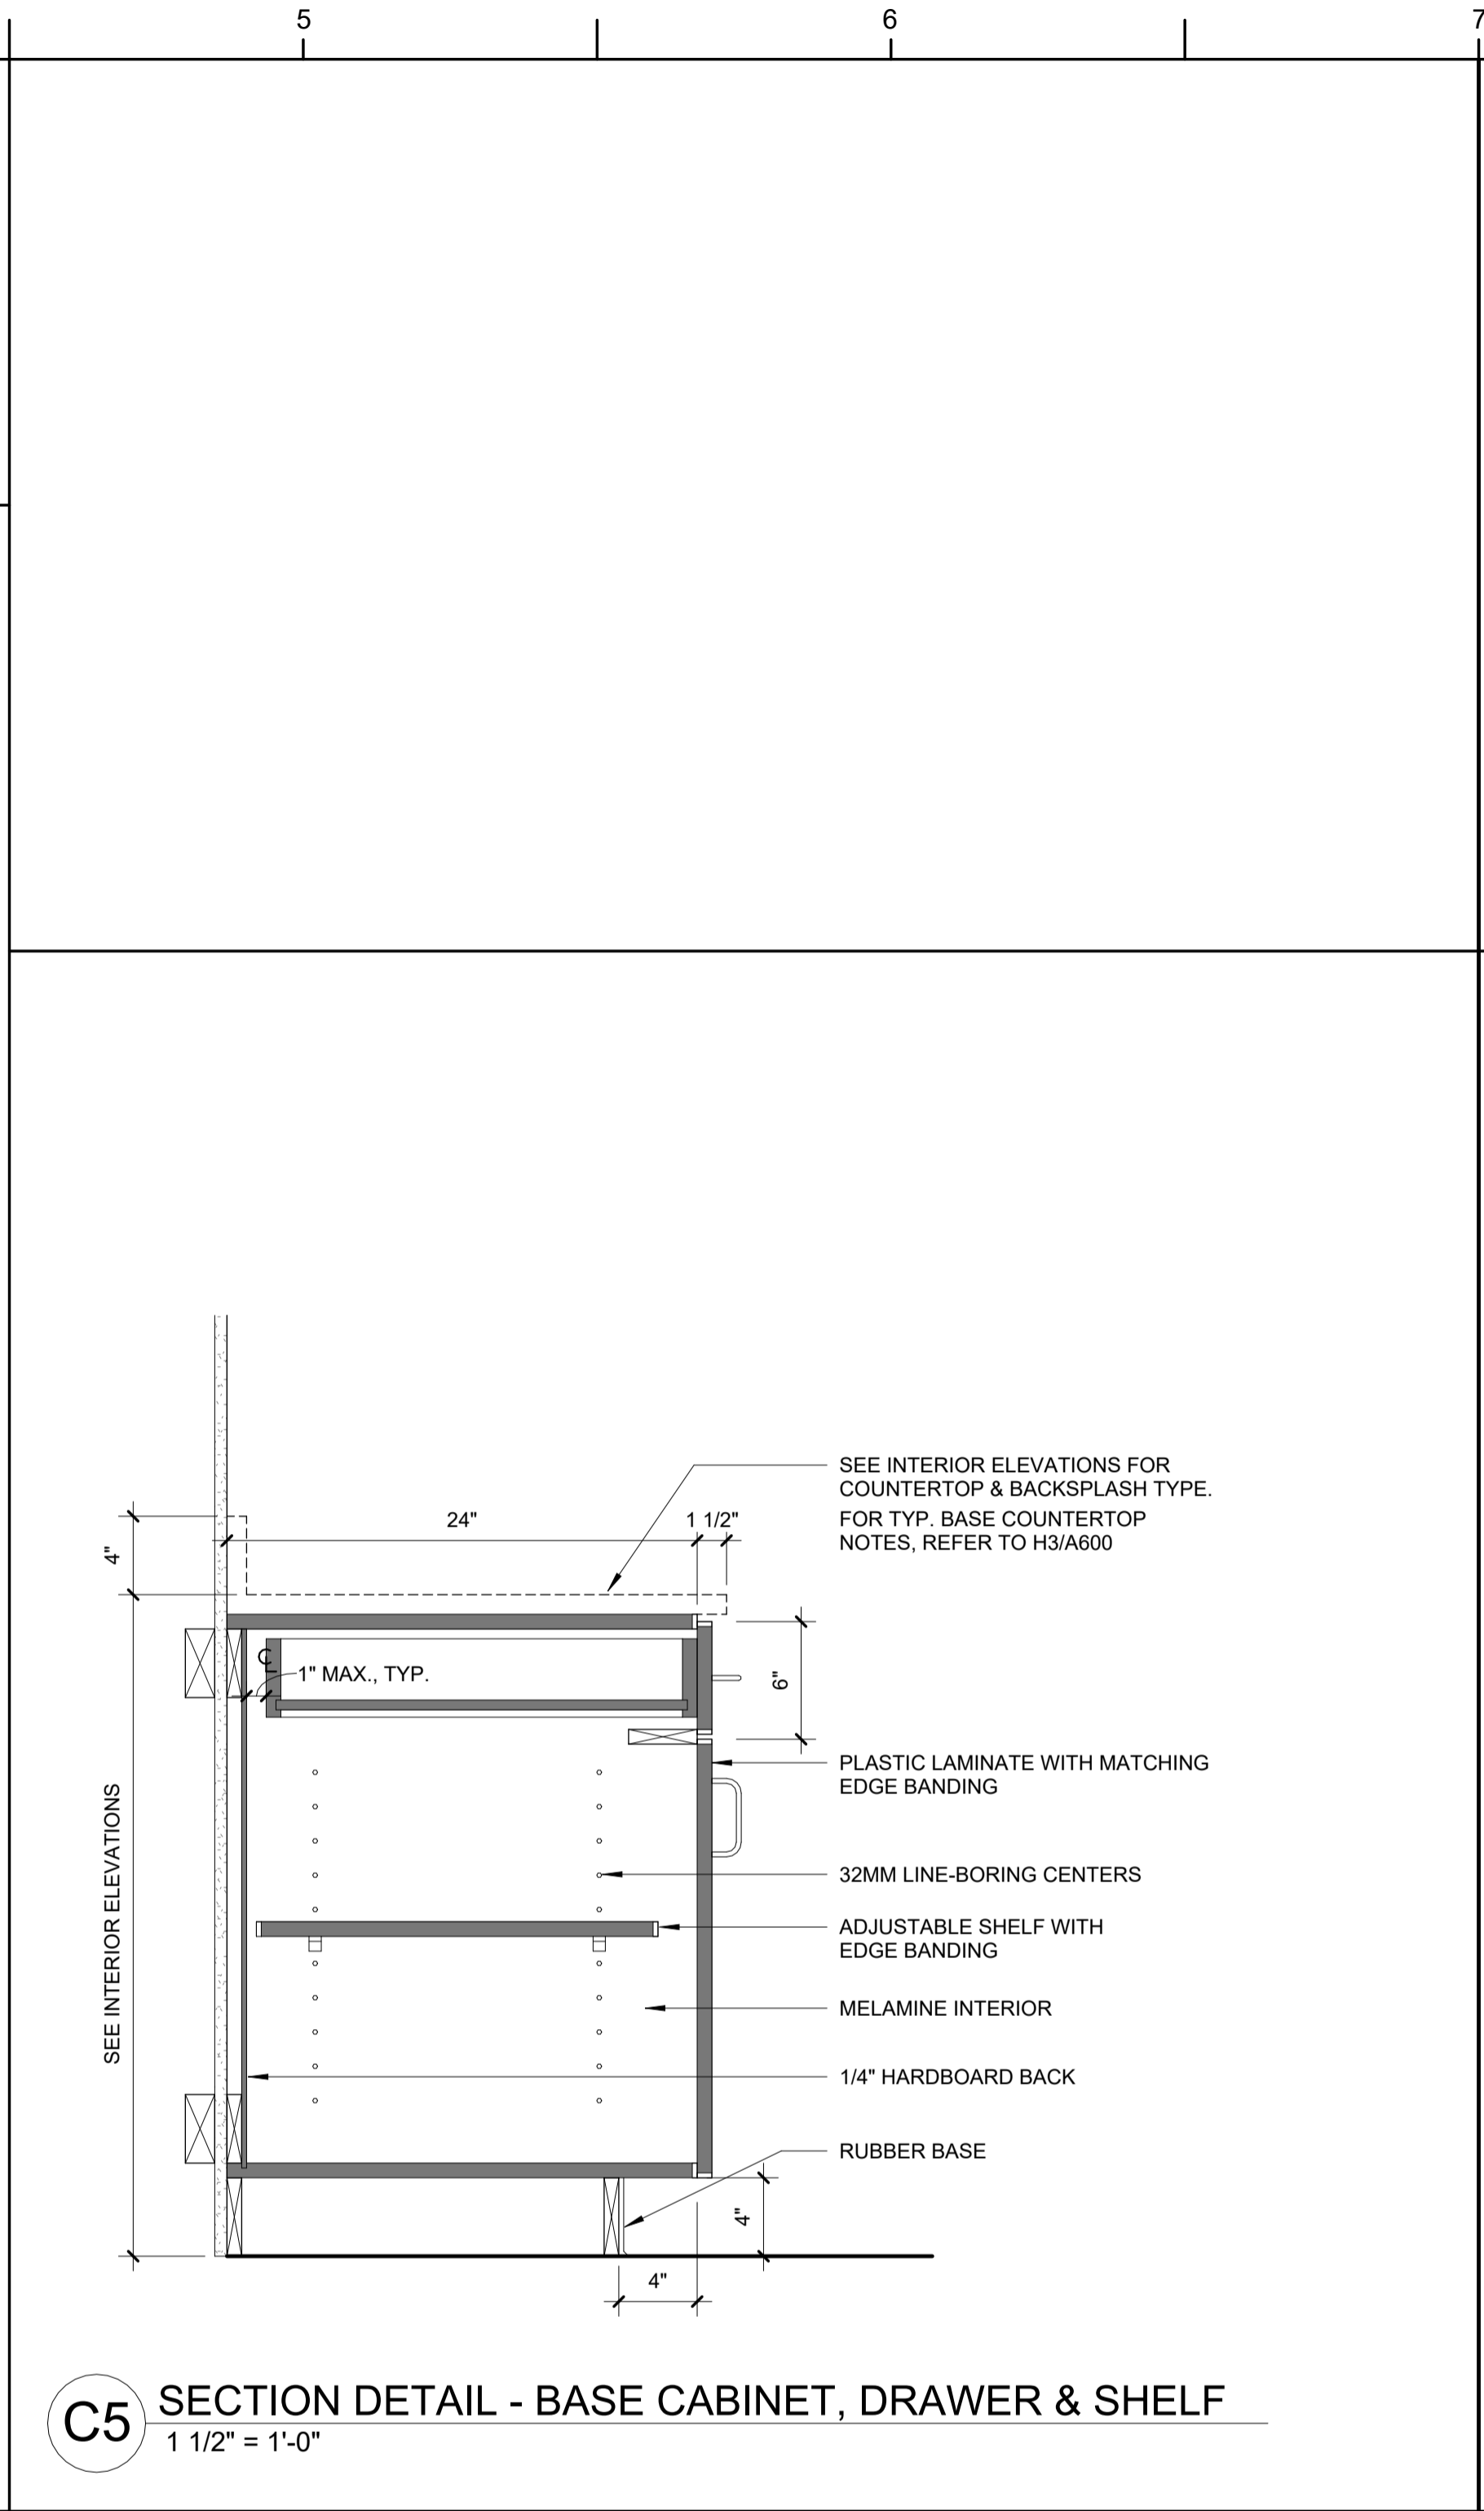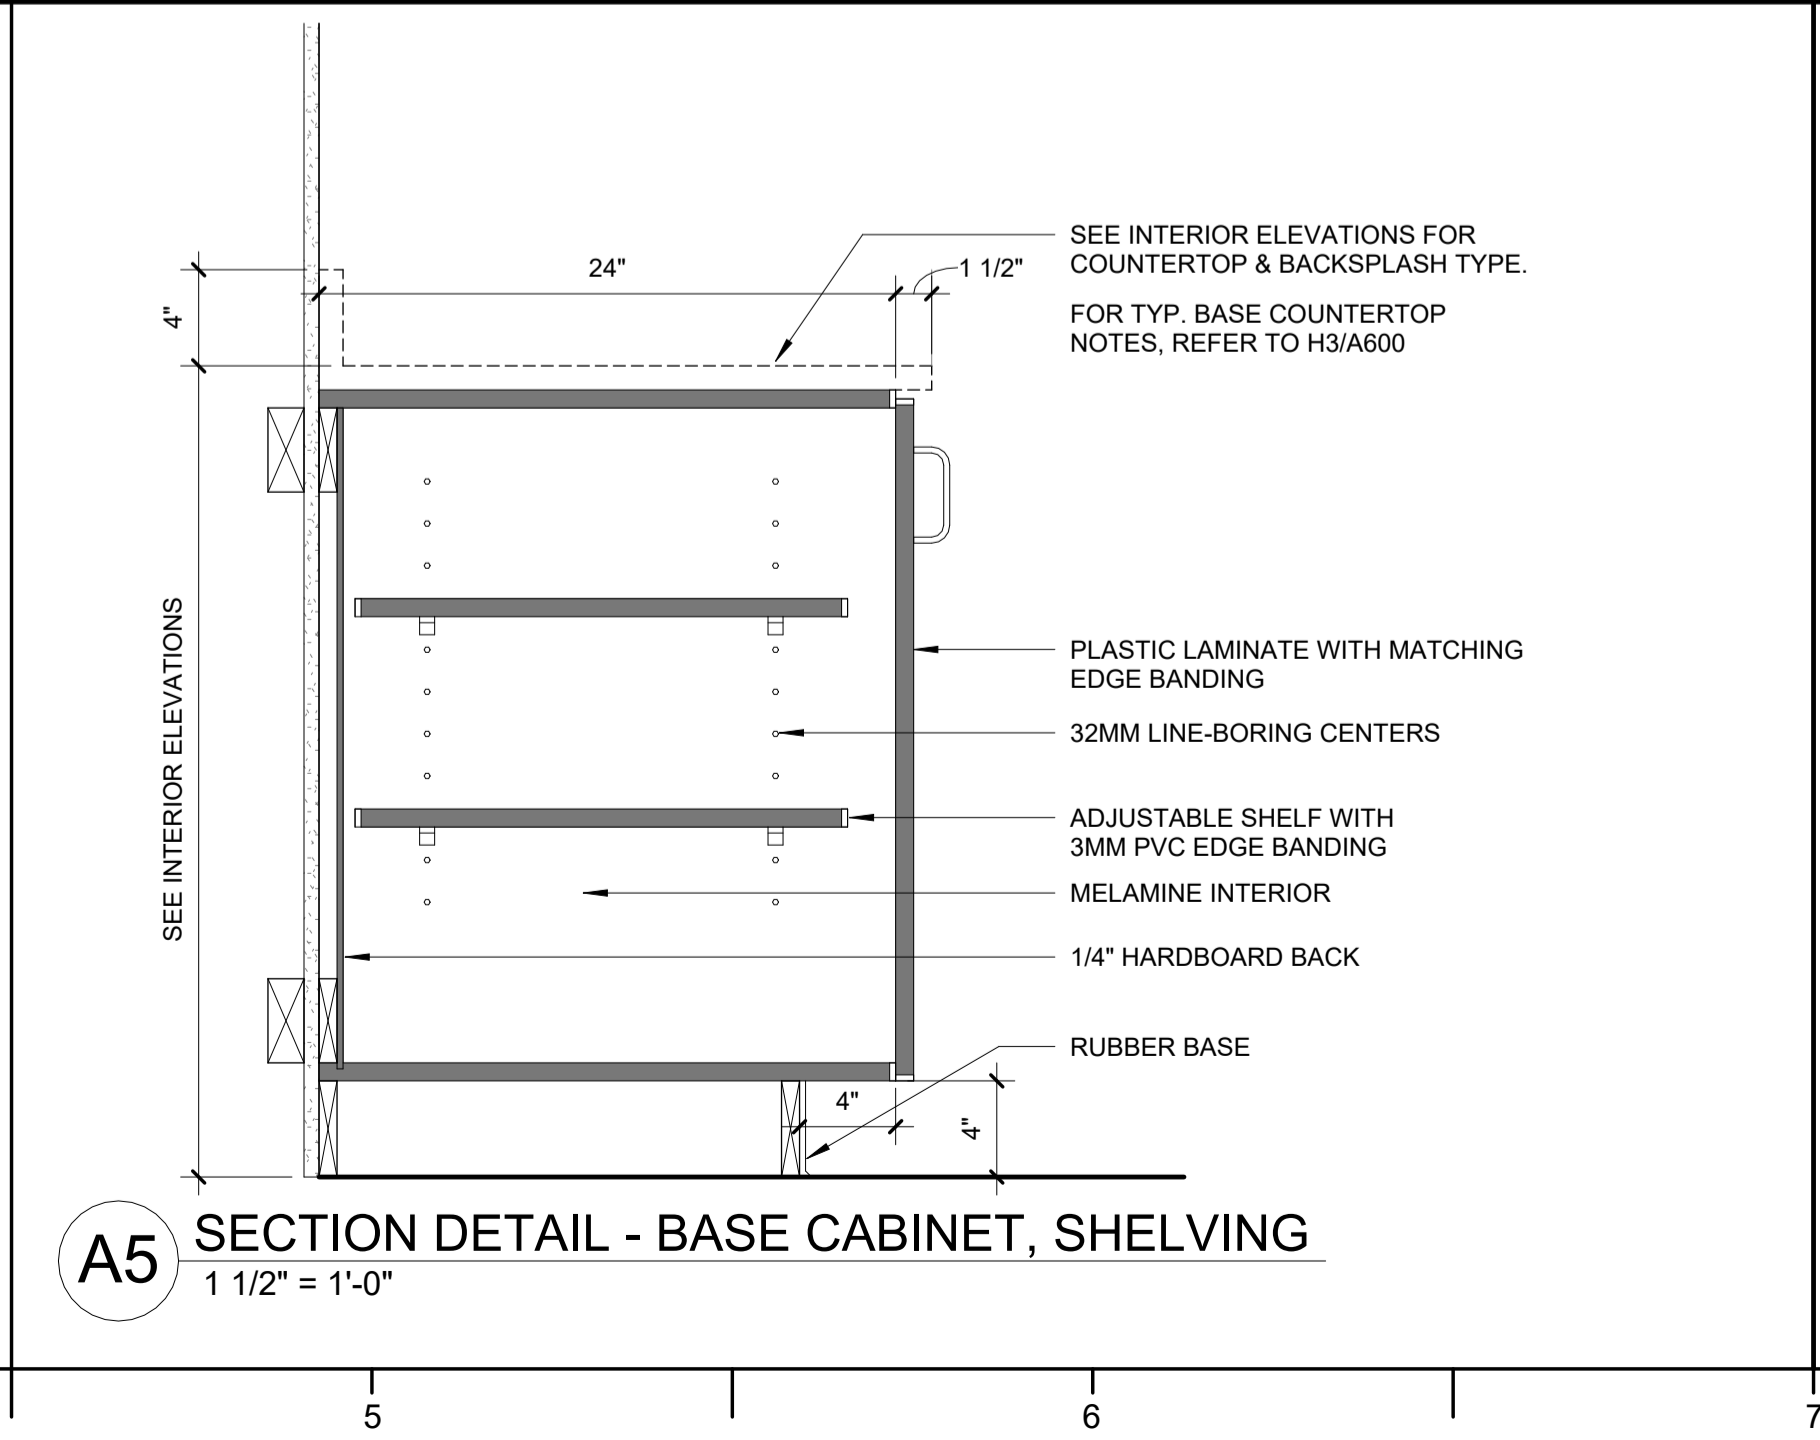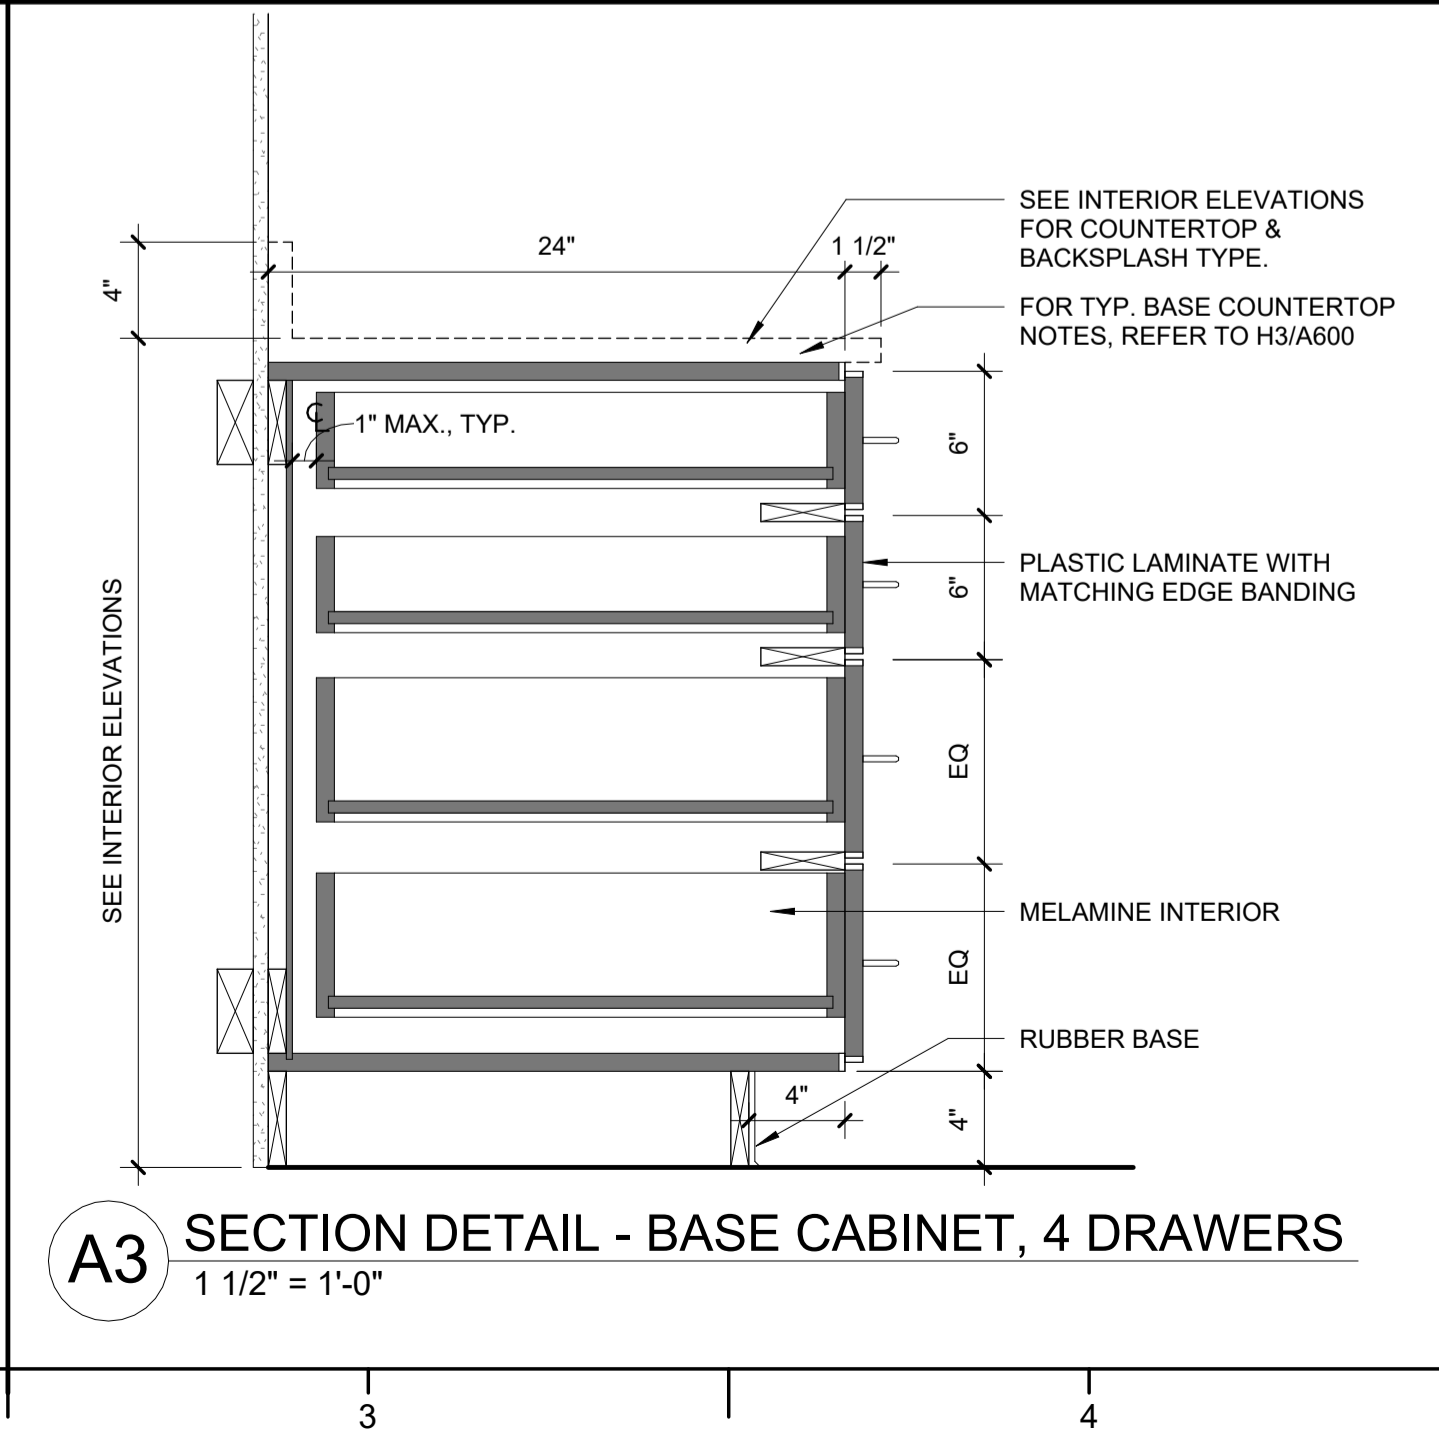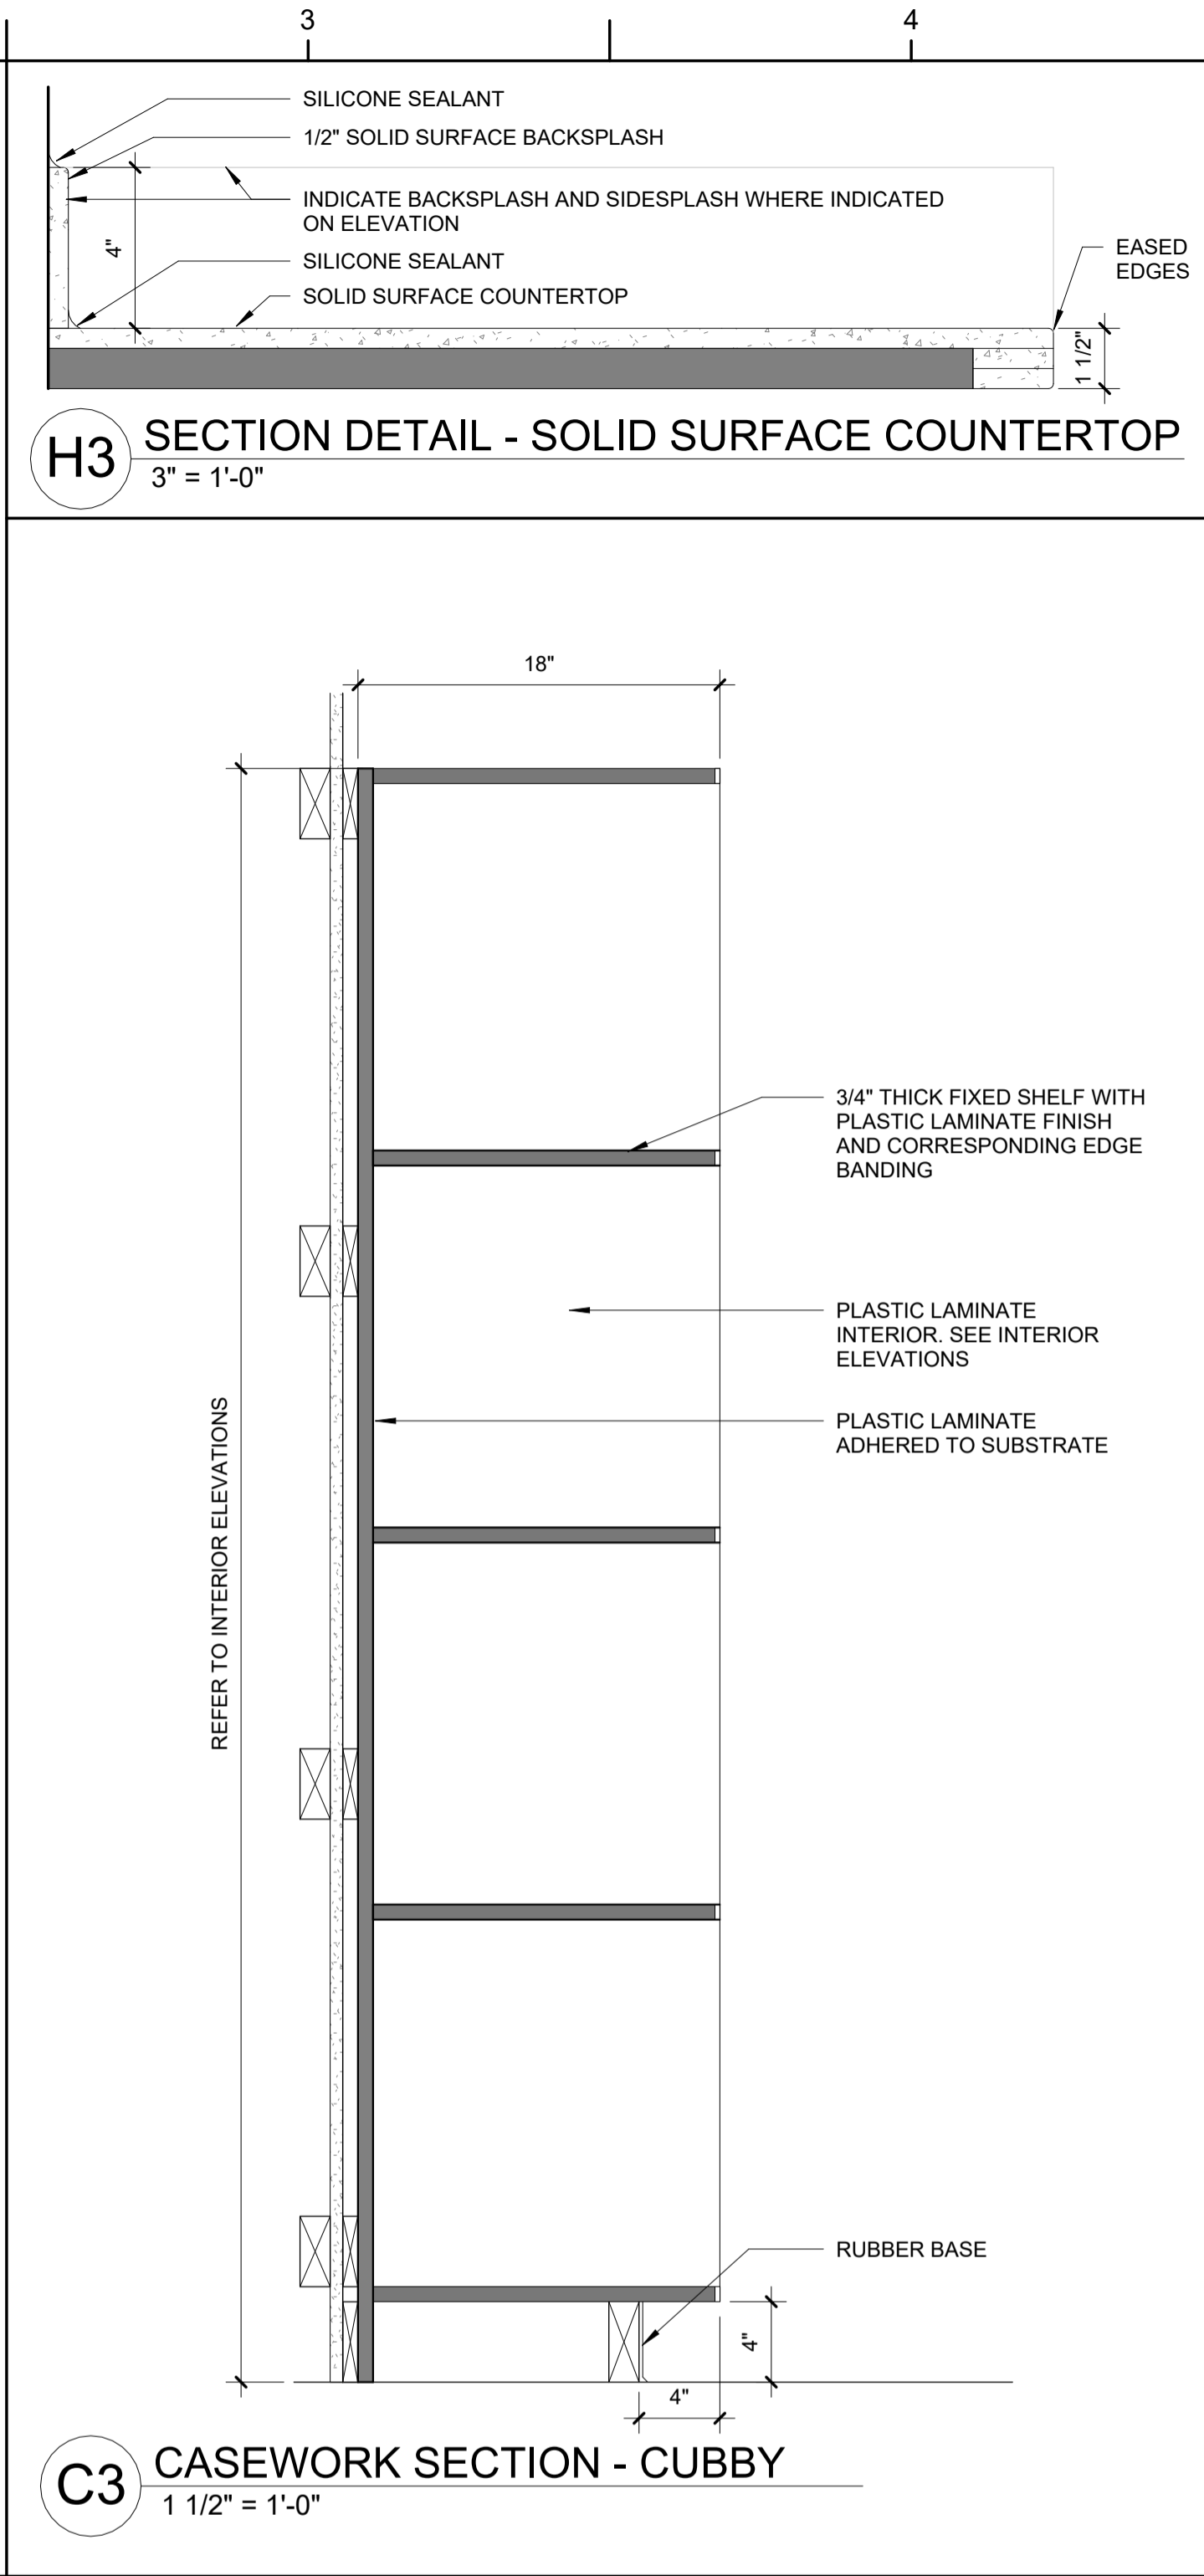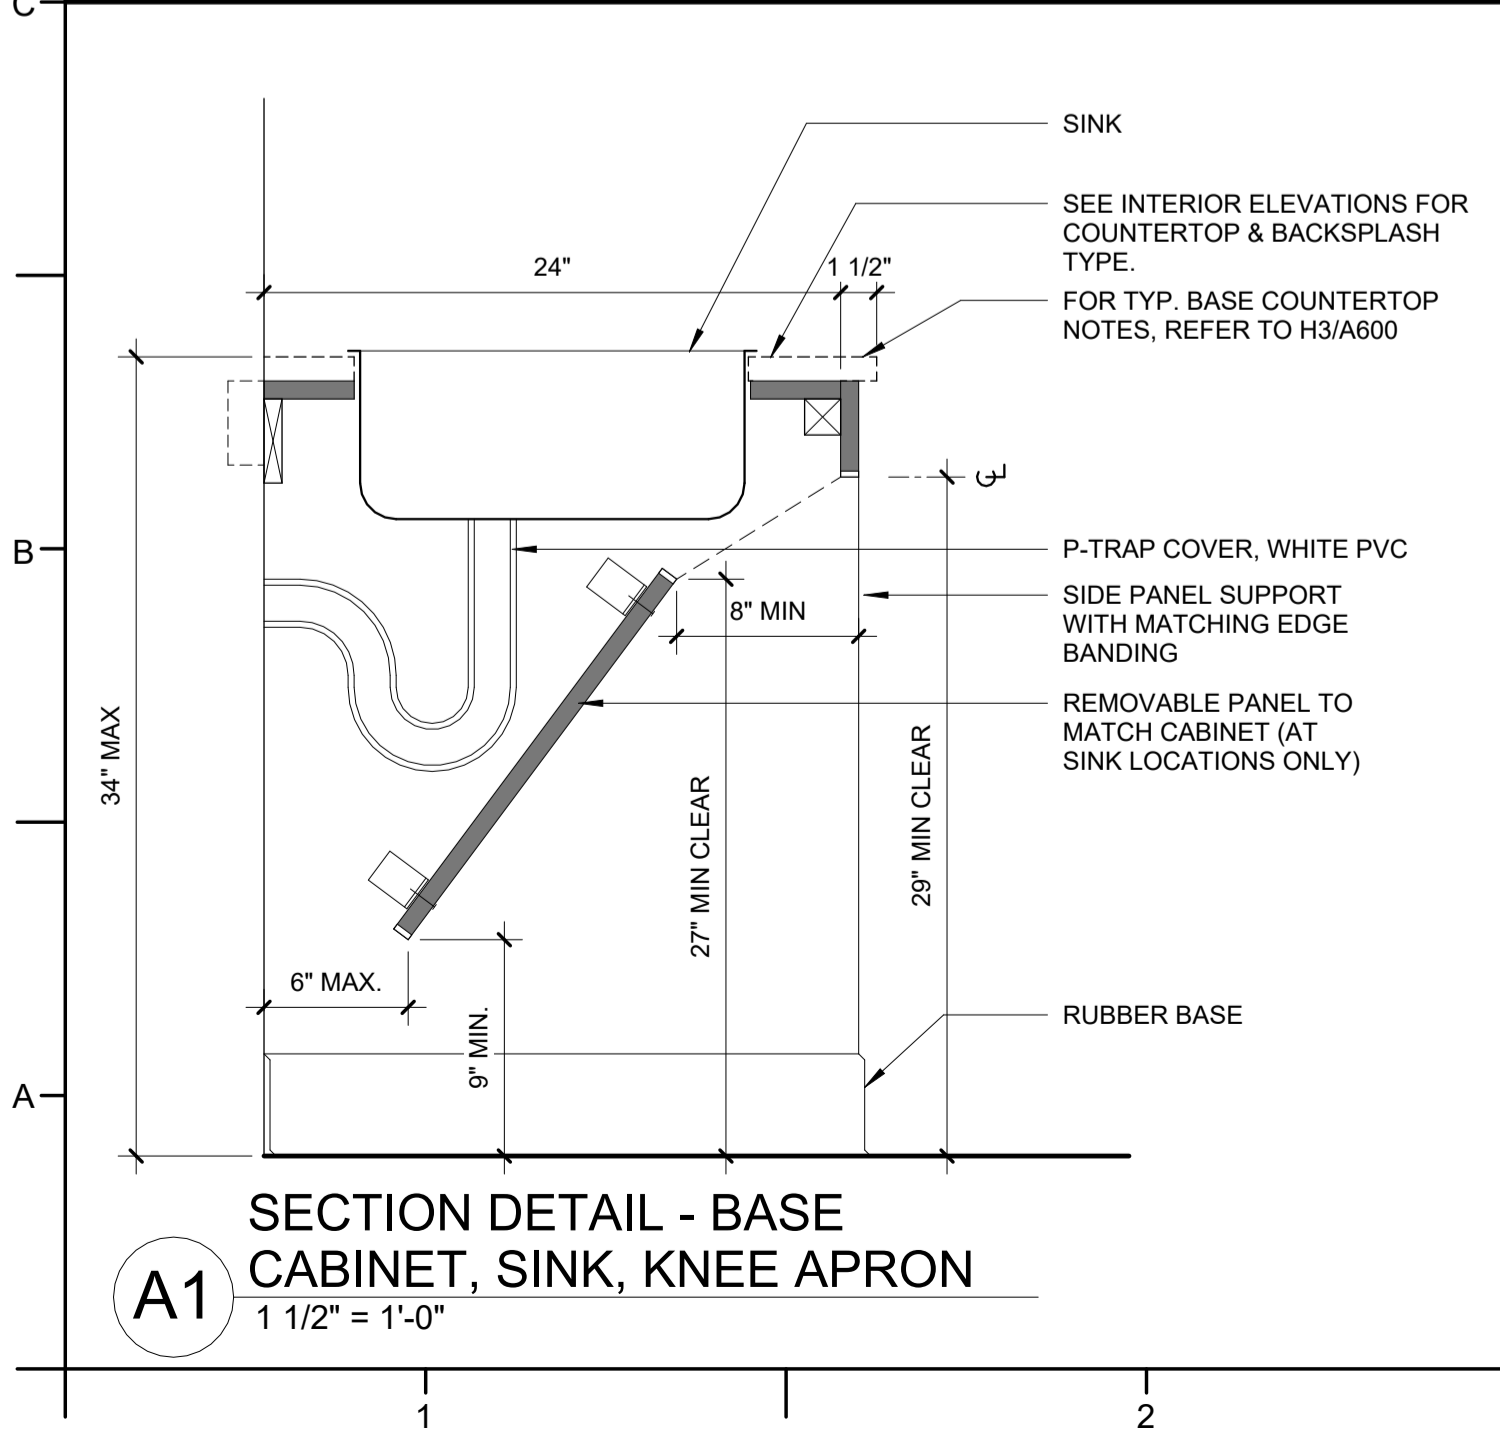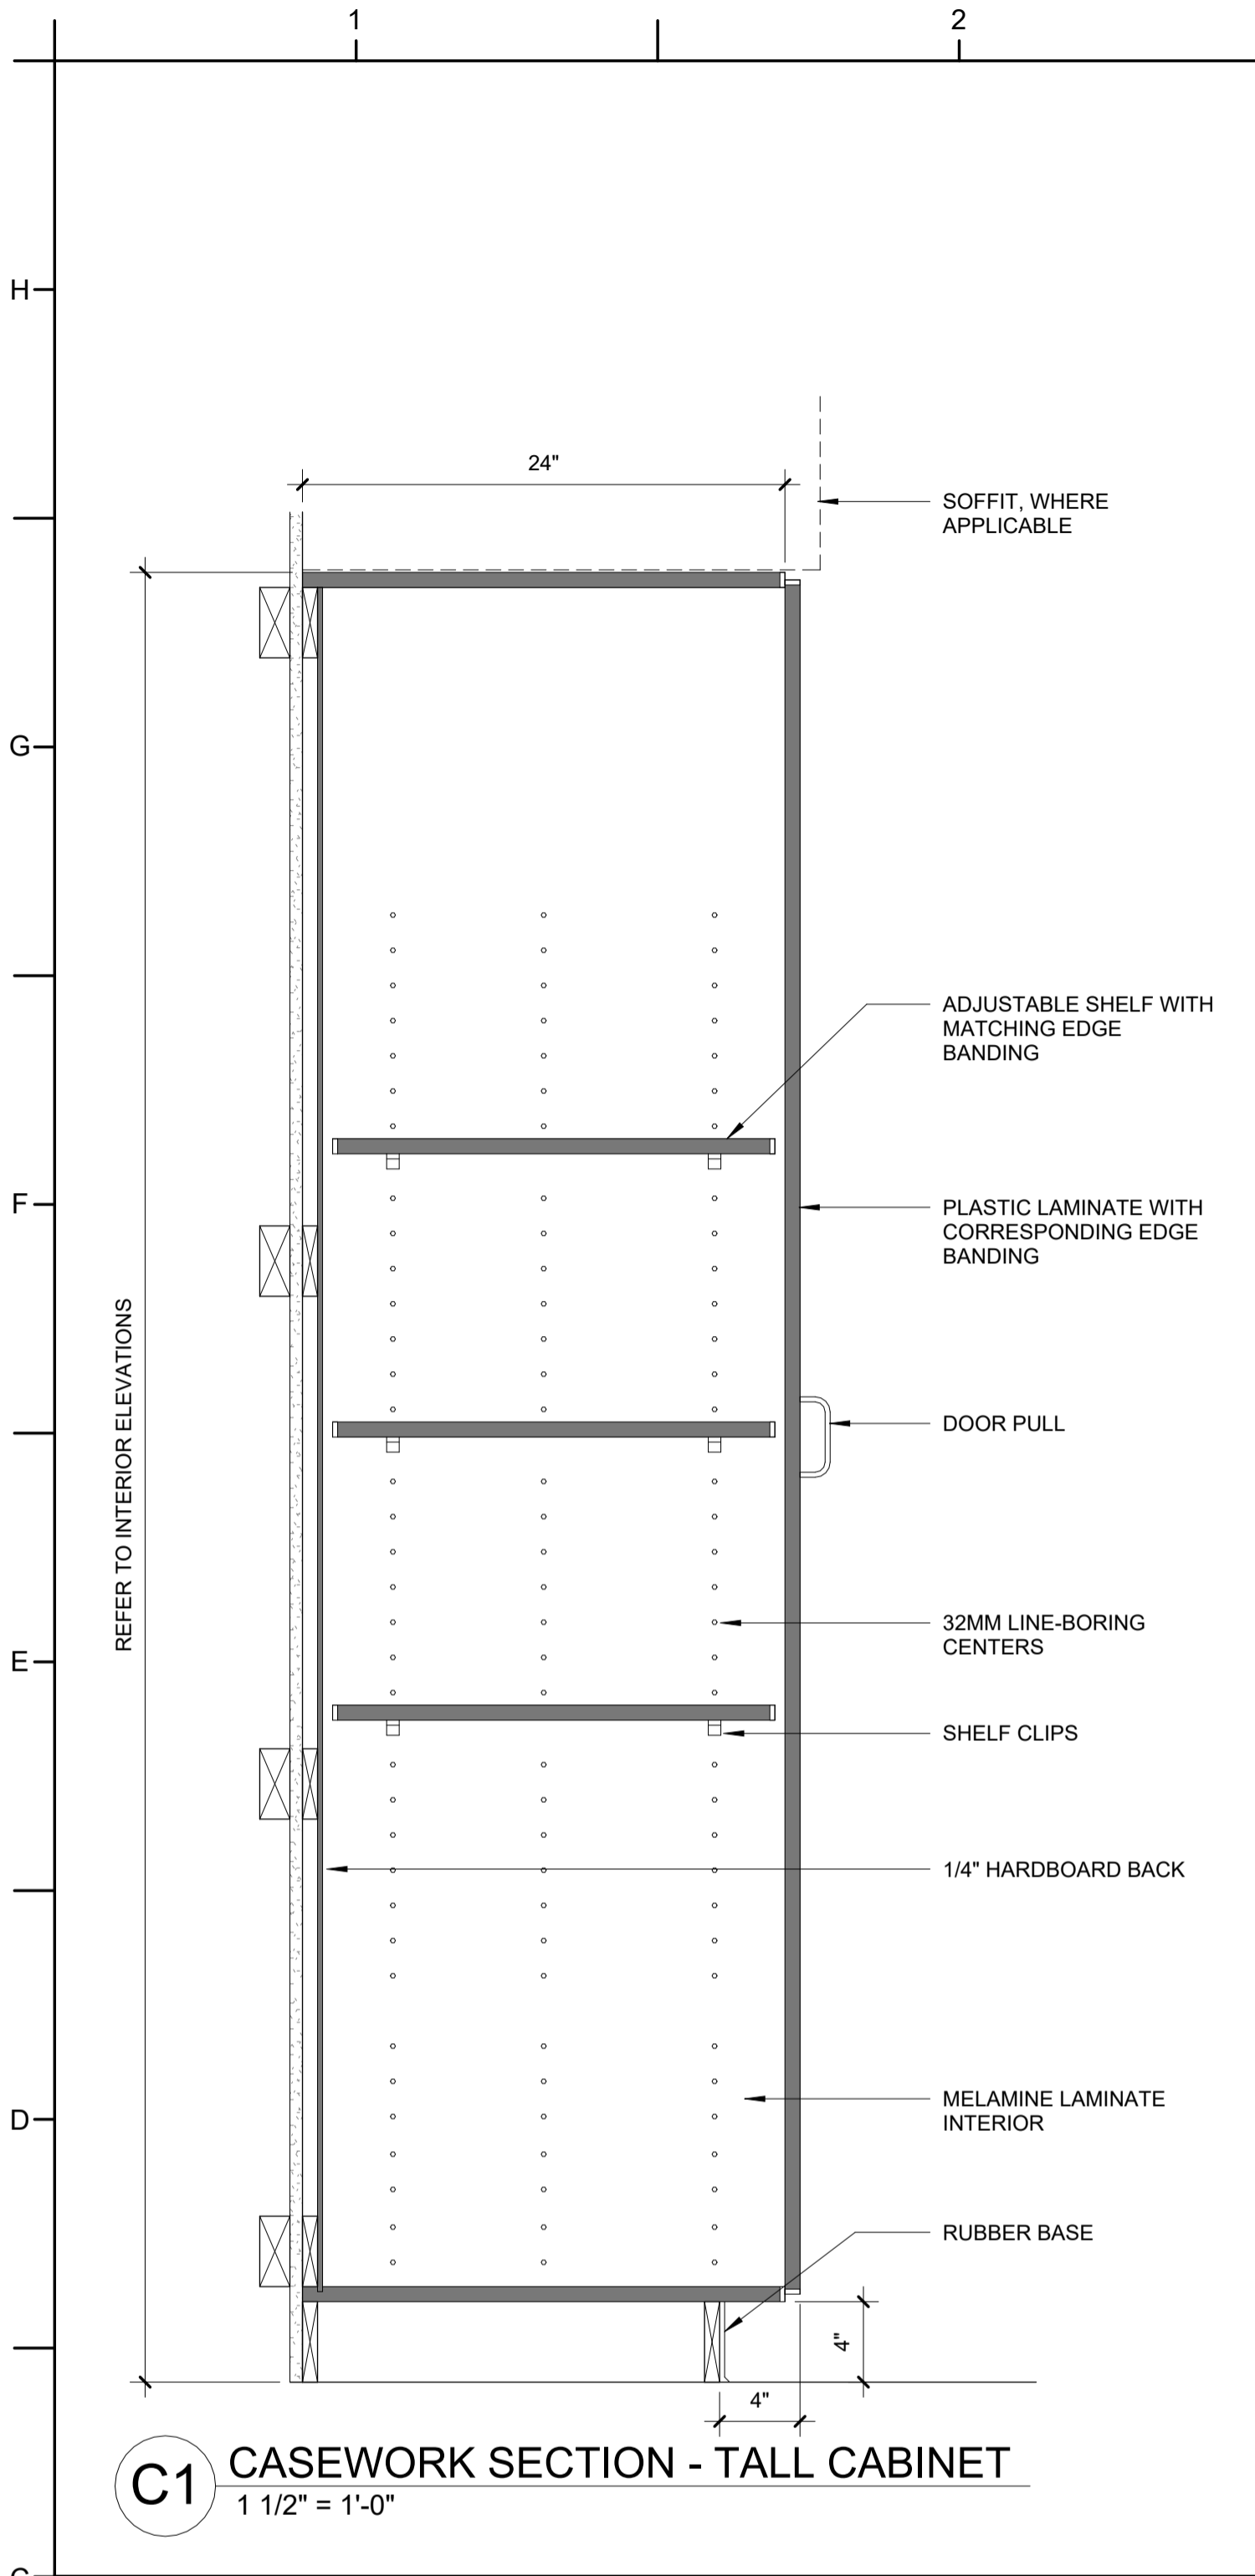

### CASEWORK GENERAL NOTES:

- SHELVES WIDER THAN 30" TO BE 1" THICK. SHELVES 30" WIDE OR NARROWER TO BE 3/4" THICK, UON.
- NUMBER OF SHELVES, DOORS AND DRAWERS TO BE AS INDICATED ON INTERIOR ELEVATIONS.
- LOCKABLE CABINETS INDICATED WITH "(L)" ON INTERIOR ELEVATIONS.
- 3/4" PARTICLEBOARD, UON.
- SEE INTERIOR ELEVATIONS FOR DIMENSIONS NOT NOTED.
- OPEN CABINETS TO HAVE THE SAME FINISH ON THE INTERIOR OF THE CABINET AS THE EXTERIOR, UON.
- ALL VOIDS CREATED BY VERTICAL FILLER PANELS AT TOP OF TALL CABINETS AND TOP AND BOTTOM OF WALL CABINETS ARE TO BE INFILLED WITH FILLER PANELS TO MATCH ADJACENT SURFACES.
- REFER TO FINISHES LEGEND ON SHEET A002 FOR FINISH COLORS.

### PROJECT INFORMATION

## HOCUTT-ELLINGTON LIBRARY RENOVATION TOWN OF CLAYTON

100 CHURCH ST.  
CLAYTON, NC 27520

### SEALS



### DKA JOB NUMBER

2415

### REVISIONS

| NO. | DESCRIPTION |
|-----|-------------|
|     |             |
|     |             |
These drawings are the property of Davis Kane Architects, P.A. They may not be used for any purpose without written permission. Copyright © 2024 by Davis Kane Architects, P.A. All rights reserved.

PA: JIMMY ARDEL EDWARDS  
PM: CV  
Drawn By: BG  
Plot Date: 4/15/2025 4:25:05 PM

### DATE ISSUED

BID DOCUMENTS

03/10/2025

**SHEET TITLE**  
CASEWORK  
DETAILS

**A601**

PROJECT INFORMATION

HOCUTT-ELLINGTON  
LIBRARY RENOVATION  
TOWN OF CLAYTON

100 CHURCH ST.  
CLAYTON, NC 27520

SEALS



DKA JOB NUMBER

2415

REVISIONS

|   |       |          |
|---|-------|----------|
| 1 | ADD 1 | 04/10/25 |
| 2 | ADD 2 | 04/17/25 |

These drawings are the property of Davis Kane Architects, P.A. They may not be reused for any purpose without written permission.  
Copyright © 2024 by Davis Kane Architects, P.A.  
All rights reserved.

PA: JIMMY ARDEL EDWARDS  
PM: CV  
Drawn By: BG  
Plot Date: 4/15/2025 4:25:07 PM

DATE ISSUED


BID DOCUMENTS

03/10/2025


SHEET TITLE

FINISH PLAN &  
SIGNAGE

I100

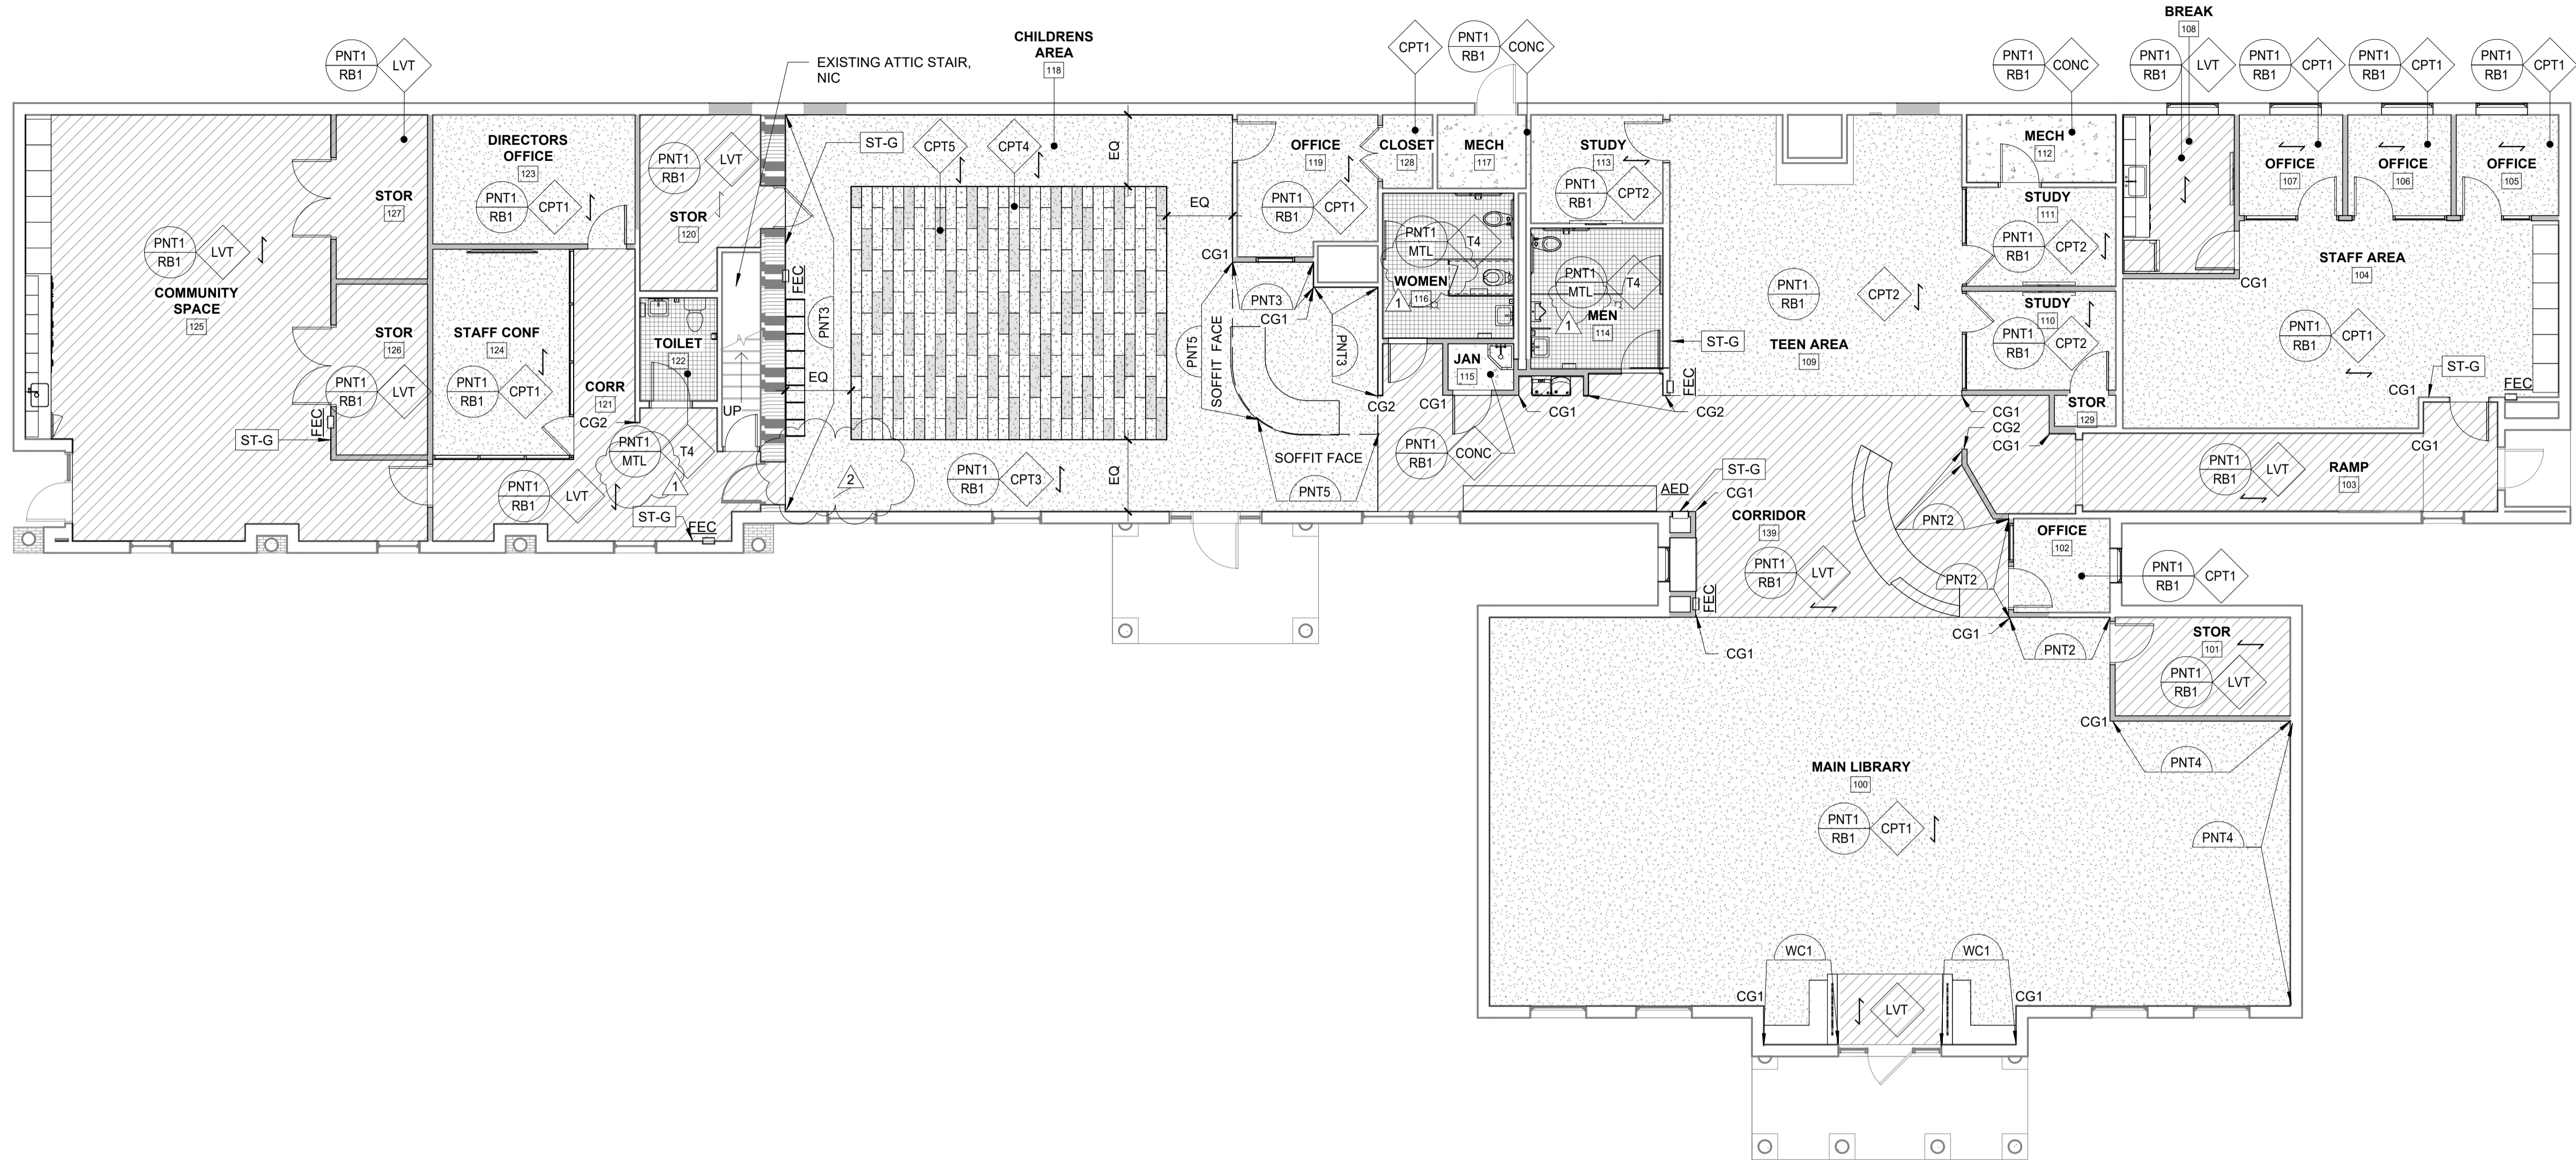


D1 FINISH PLAN  
1/8" = 1'-0"

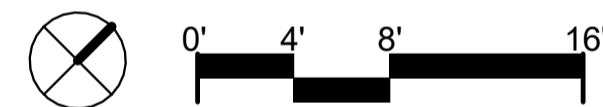


FINISHES GENERAL NOTES:

- SEE FLOOR PLANS FOR WALL TYPES.
- SEE INTERIOR ELEVATIONS AND DETAILS FOR LOCATION OF CASEWORK AND WALL FINISH SELECTIONS NOT SHOWN ON PLAN.
- PAINT COLORS PROVIDED IN MATERIAL LEGEND ARE FOR COLOR MATCH ONLY.
- INTERIOR FINISH ACCENTS INDICATED AT LOCATION BY SYMBOL, WITH LEADER DESIGNATION.
- FOR CEILING FINISH AND COLORS REFER TO REFLECTED CEILING PLANS.
- REFER TO SHEET A002 FOR MATERIAL LEGEND
- ALL WALLS TO BE PNT1, U.O.N.
- REFER TO INTERIOR ELEVATIONS FOR WALL TILE PLACEMENT AND TYPES.
- UNLESS SHOWN OTHERWISE, FINISH TAGS SHOWN APPLY TO ENTIRETY OF EACH ROOM.

FINISH PLAN SYMBOL LEGEND

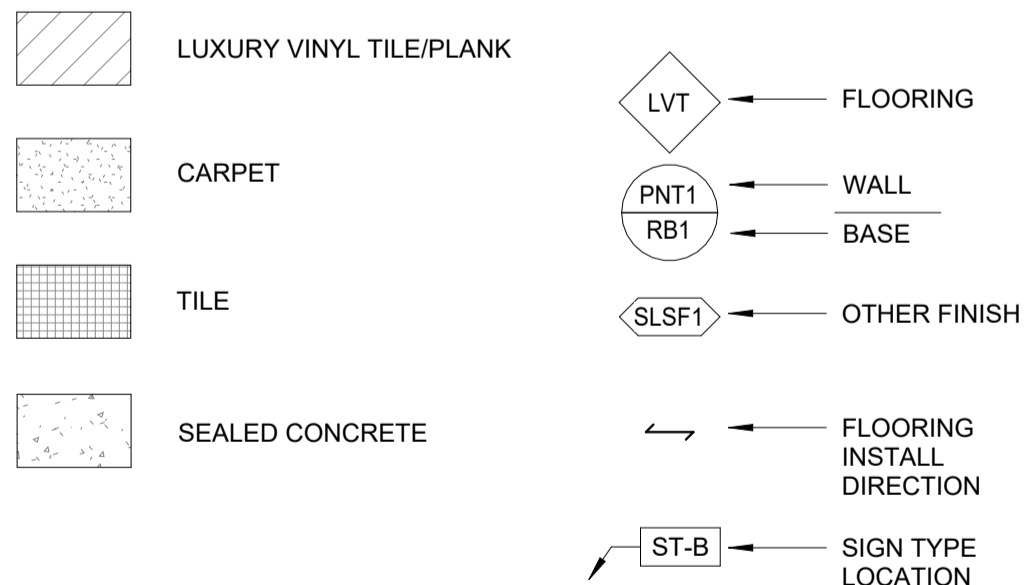


SIGN TYPE ELEVATIONS

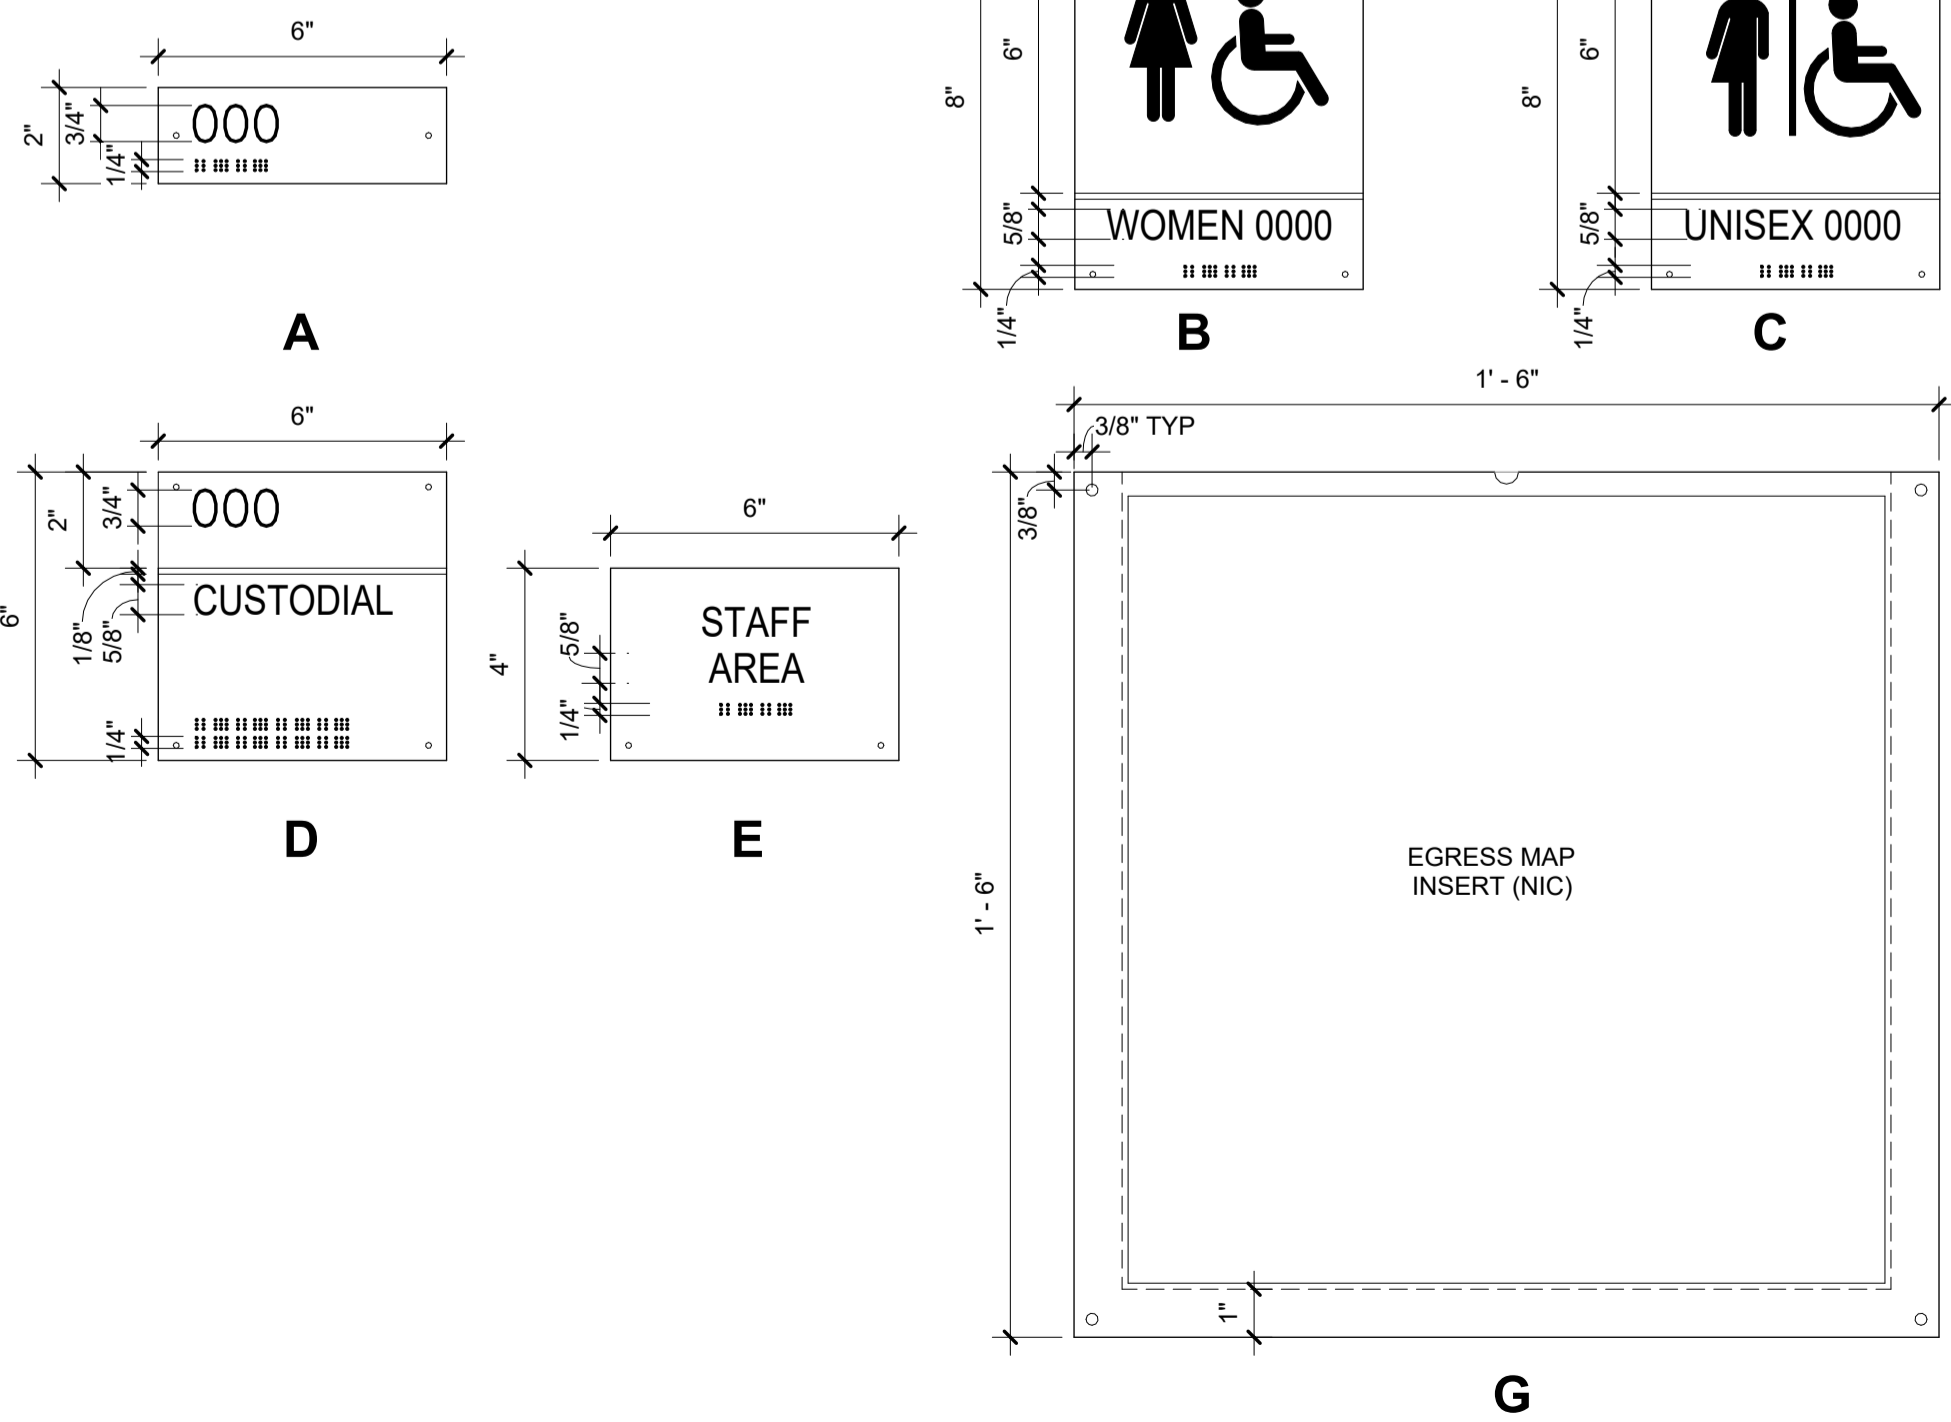

INTERIOR SIGNAGE NOTES:

- REFERENCE DOOR SCHEDULE FOR SIGNAGE LOCATIONS.
- TEXT SHOWN ON SIGNS IS SAMPLE TEXT ONLY.
- SEE SHEET A001 FOR MOUNTING HEIGHTS.
- SEE INTERIOR FINISHES PLANS FOR SIGNAGE LOCATIONS NOT NOTED IN DOOR SCHEDULE. ON FINISHES PLANS, "ST" DENOTES SIGN TYPE. FOR EXAMPLE, "ST-K" DENOTES SIGN TYPE K.

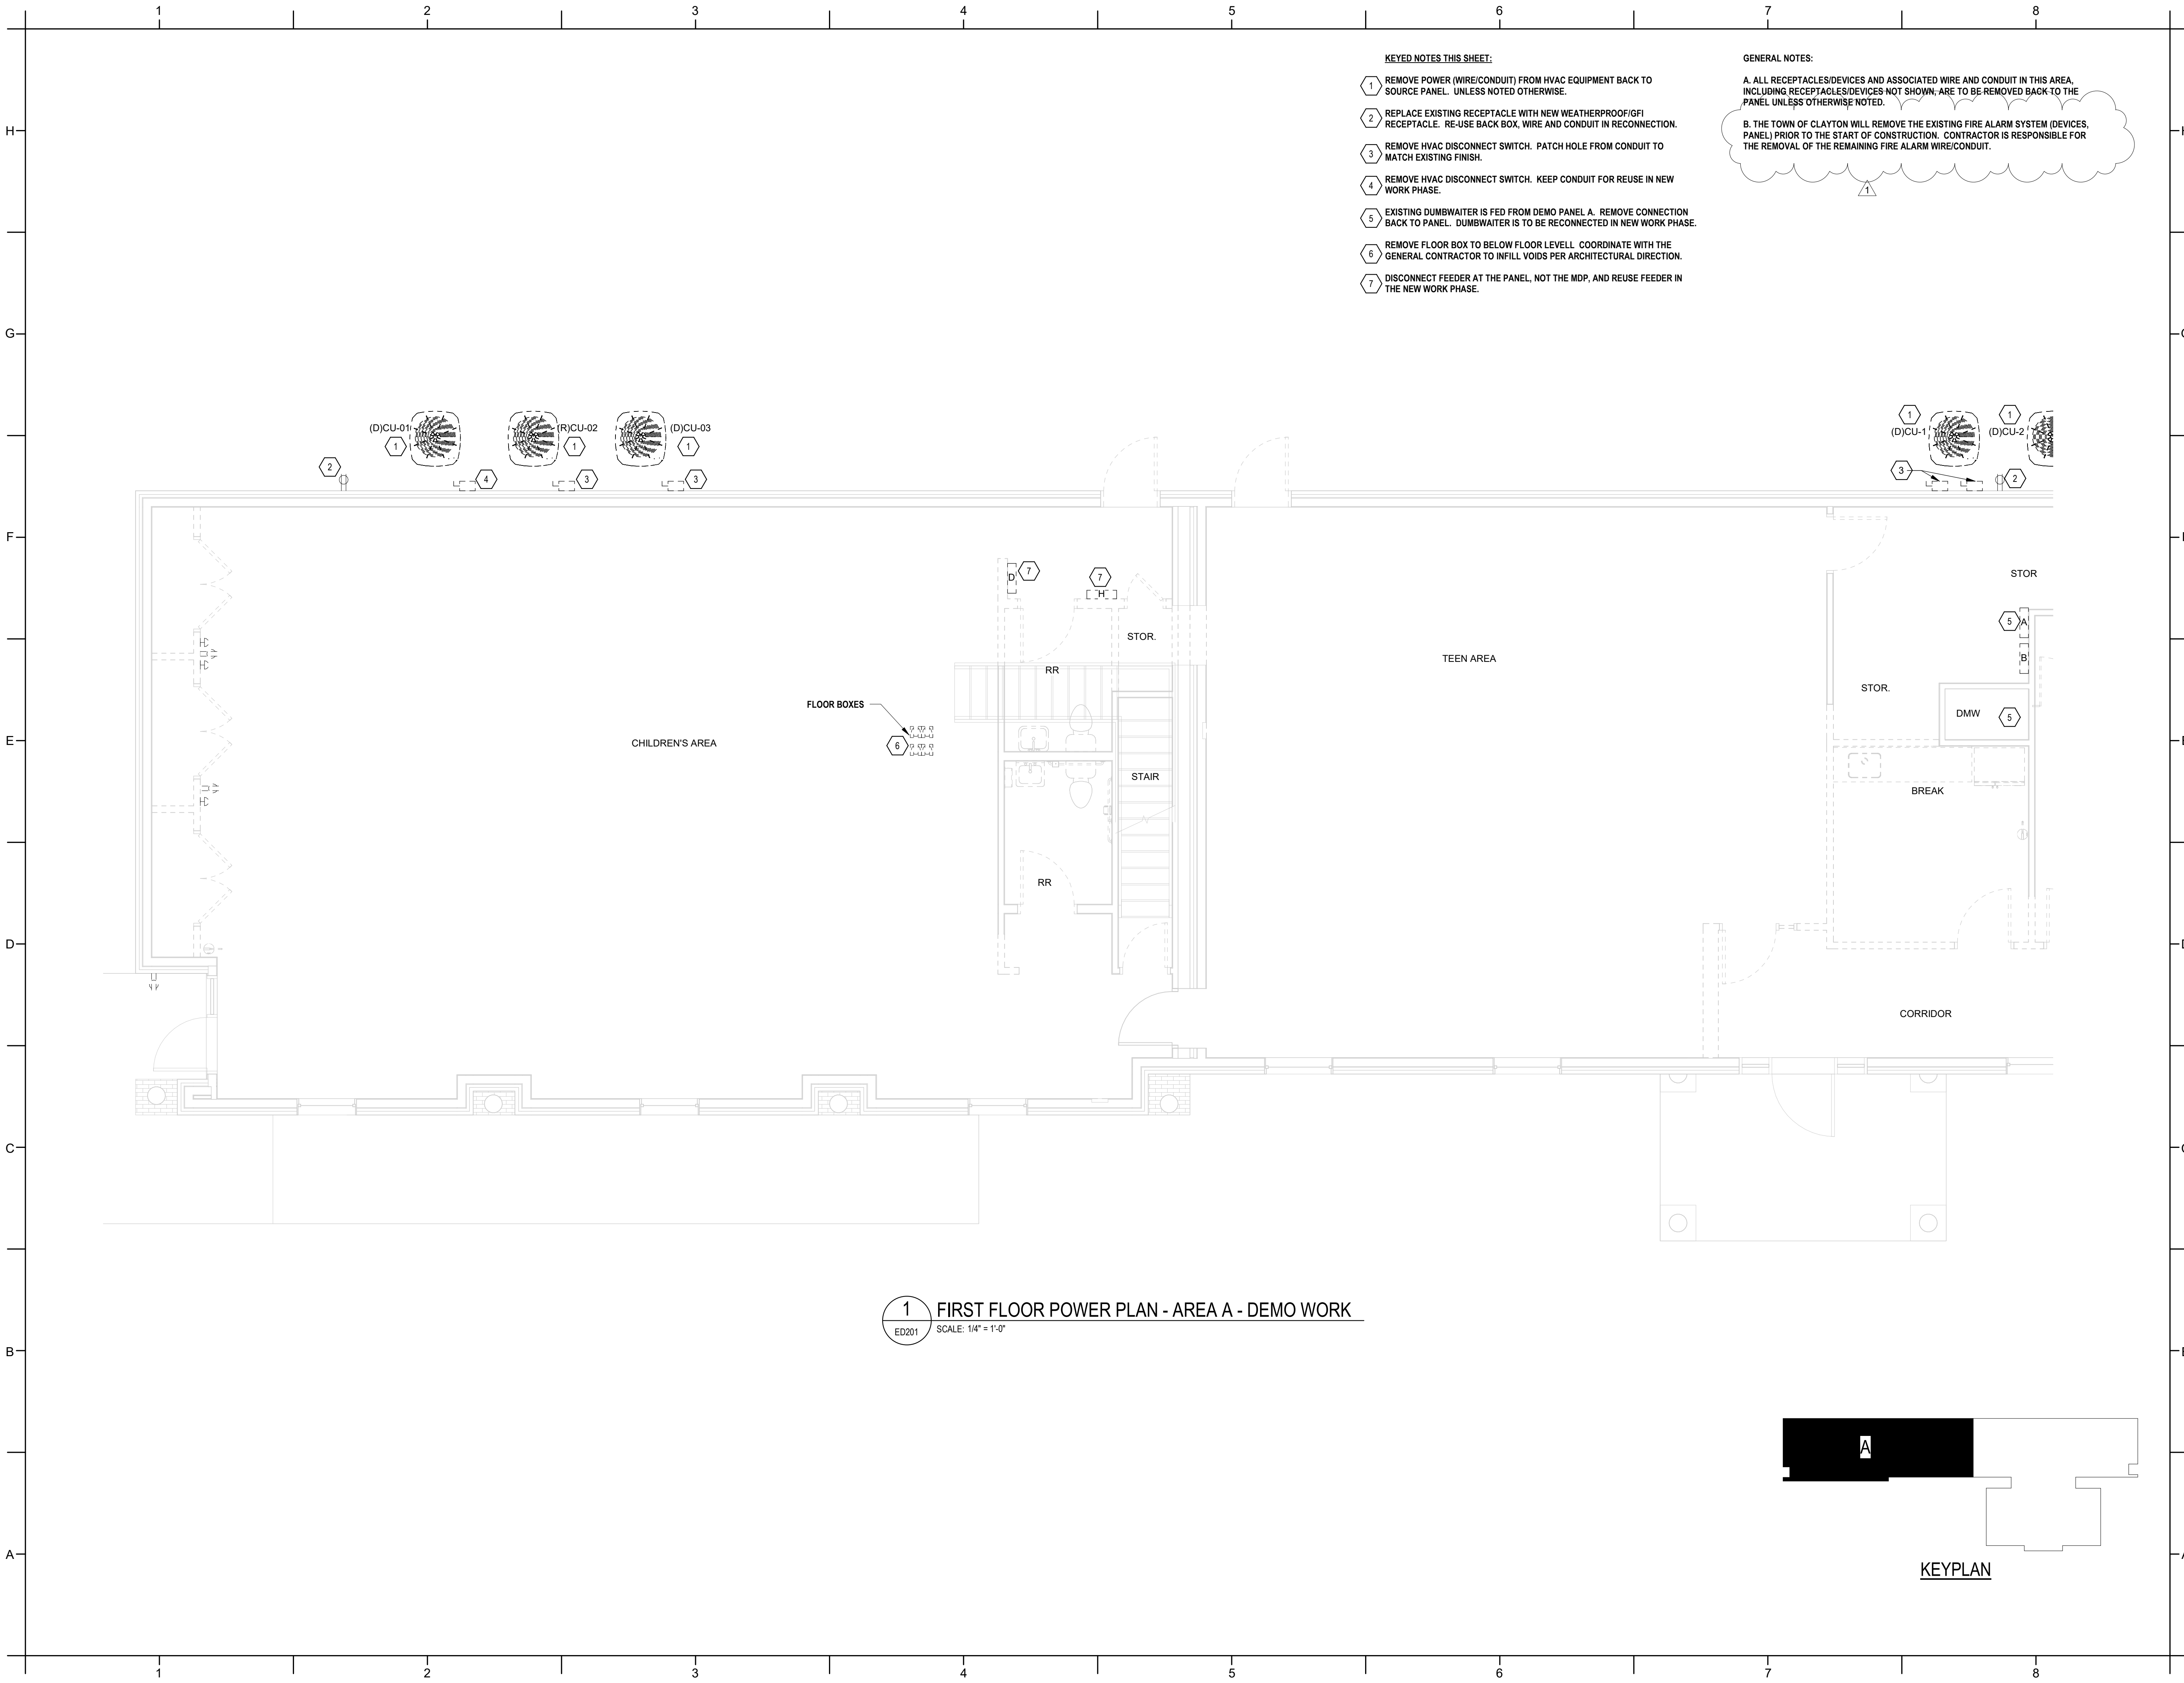

1 FIRST FLOOR POWER PLAN - AREA A - DEMO WORK  
ED201 SCALE: 1/4" = 1'-0"

- KEYED NOTES THIS SHEET:**
- 1 REMOVE POWER (WIRE/CONDUIT) FROM HVAC EQUIPMENT BACK TO SOURCE PANEL. UNLESS NOTED OTHERWISE.
  - 2 REPLACE EXISTING RECEPTACLE WITH NEW WEATHERPROOF/GFI RECEPTACLE. RE-USE BACK BOX, WIRE AND CONDUIT IN RECONNECTION.
  - 3 REMOVE HVAC DISCONNECT SWITCH. PATCH HOLE FROM CONDUIT TO MATCH EXISTING FINISH.
  - 4 REMOVE HVAC DISCONNECT SWITCH. KEEP CONDUIT FOR REUSE IN NEW WORK PHASE.
  - 5 EXISTING DUMBWAITER IS FED FROM DEMO PANEL A. REMOVE CONNECTION BACK TO PANEL. DUMBWAITER IS TO BE RECONNECTED IN NEW WORK PHASE.
  - 6 REMOVE FLOOR BOX TO BELOW FLOOR LEVEL. COORDINATE WITH THE GENERAL CONTRACTOR TO INFILL VOIDS PER ARCHITECTURAL DIRECTION.
  - 7 DISCONNECT FEEDER AT THE PANEL, NOT THE MDP, AND REUSE FEEDER IN THE NEW WORK PHASE.

**GENERAL NOTES:**


A. ALL RECEPTACLES/DEVICES AND ASSOCIATED WIRE AND CONDUIT IN THIS AREA, INCLUDING RECEPTACLES/DEVICES NOT SHOWN, ARE TO BE REMOVED BACK TO THE PANEL UNLESS OTHERWISE NOTED.

B. THE TOWN OF CLAYTON WILL REMOVE THE EXISTING FIRE ALARM SYSTEM (DEVICES, PANEL) PRIOR TO THE START OF CONSTRUCTION. CONTRACTOR IS RESPONSIBLE FOR THE REMOVAL OF THE REMAINING FIRE ALARM WIRE/CONDUIT.

**PROJECT INFORMATION**

**HOCUTT-ELLINGTON**  
**LIBRARY RENOVATION**  
TOWN OF CLAYTON  
100 CHURCH ST.  
CLAYTON, NC 27520

**SEALS**

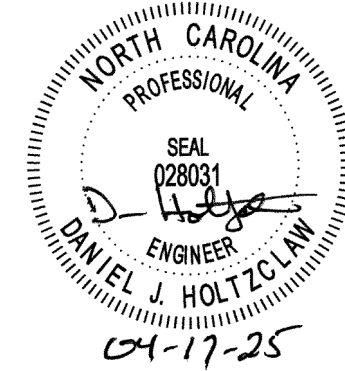

**DKA JOB NUMBER**  
2415

**REVISIONS**

| 1 | ADD. 2 | 04.17.25 |
|---|--------|----------|
|   |        |          |
|   |        |          |
These drawings are the property of Davis Kane Architects, P.A. They may not be reused for any purpose without written permission.  
Copyright © 2024 by Davis Kane Architects, P.A. All rights reserved.

PA: PM: JRQ  
Drawn By: DJH  
Plot Date: 4/17/2025 8:06:54 AM

**DATE ISSUED**

**BID DOCUMENTS**  
03/10/2025

**SHEET TITLE**  
ELECTRICAL FLOOR  
PLAN - POWER  
DEMO - AREA A



**ED201**

PROJECT INFORMATION

HOCUTT-ELLINGTON  
LIBRARY RENOVATION  
TOWN OF CLAYTON

100 CHURCH ST.  
CLAYTON, NC 27520

SEALS

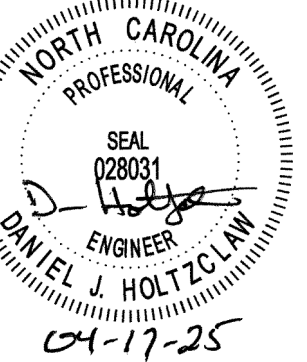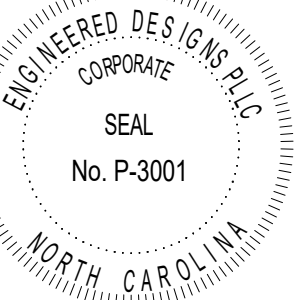

DKA JOB NUMBER  
2415

REVISIONS

|   |        |          |
|---|--------|----------|
| 1 | ADD. 2 | 04.17.25 |
|   |        |          |
|   |        |          |
These drawings are the property of Davis Kane Architects, P.A. They may not be reused for any purpose without written permission.  
Copyright © 2024 by Davis Kane Architects, P.A. All rights reserved.


PA:  
PM: JRQ  
Drawn By: DJH  
Plot Date: 4/17/2025 8:10:56 AM

DATE ISSUED

BID DOCUMENTS  
03/10/2025

SHEET TITLE  
ELECTRICAL FLOOR  
PLAN - POWER -  
AREA A

E201

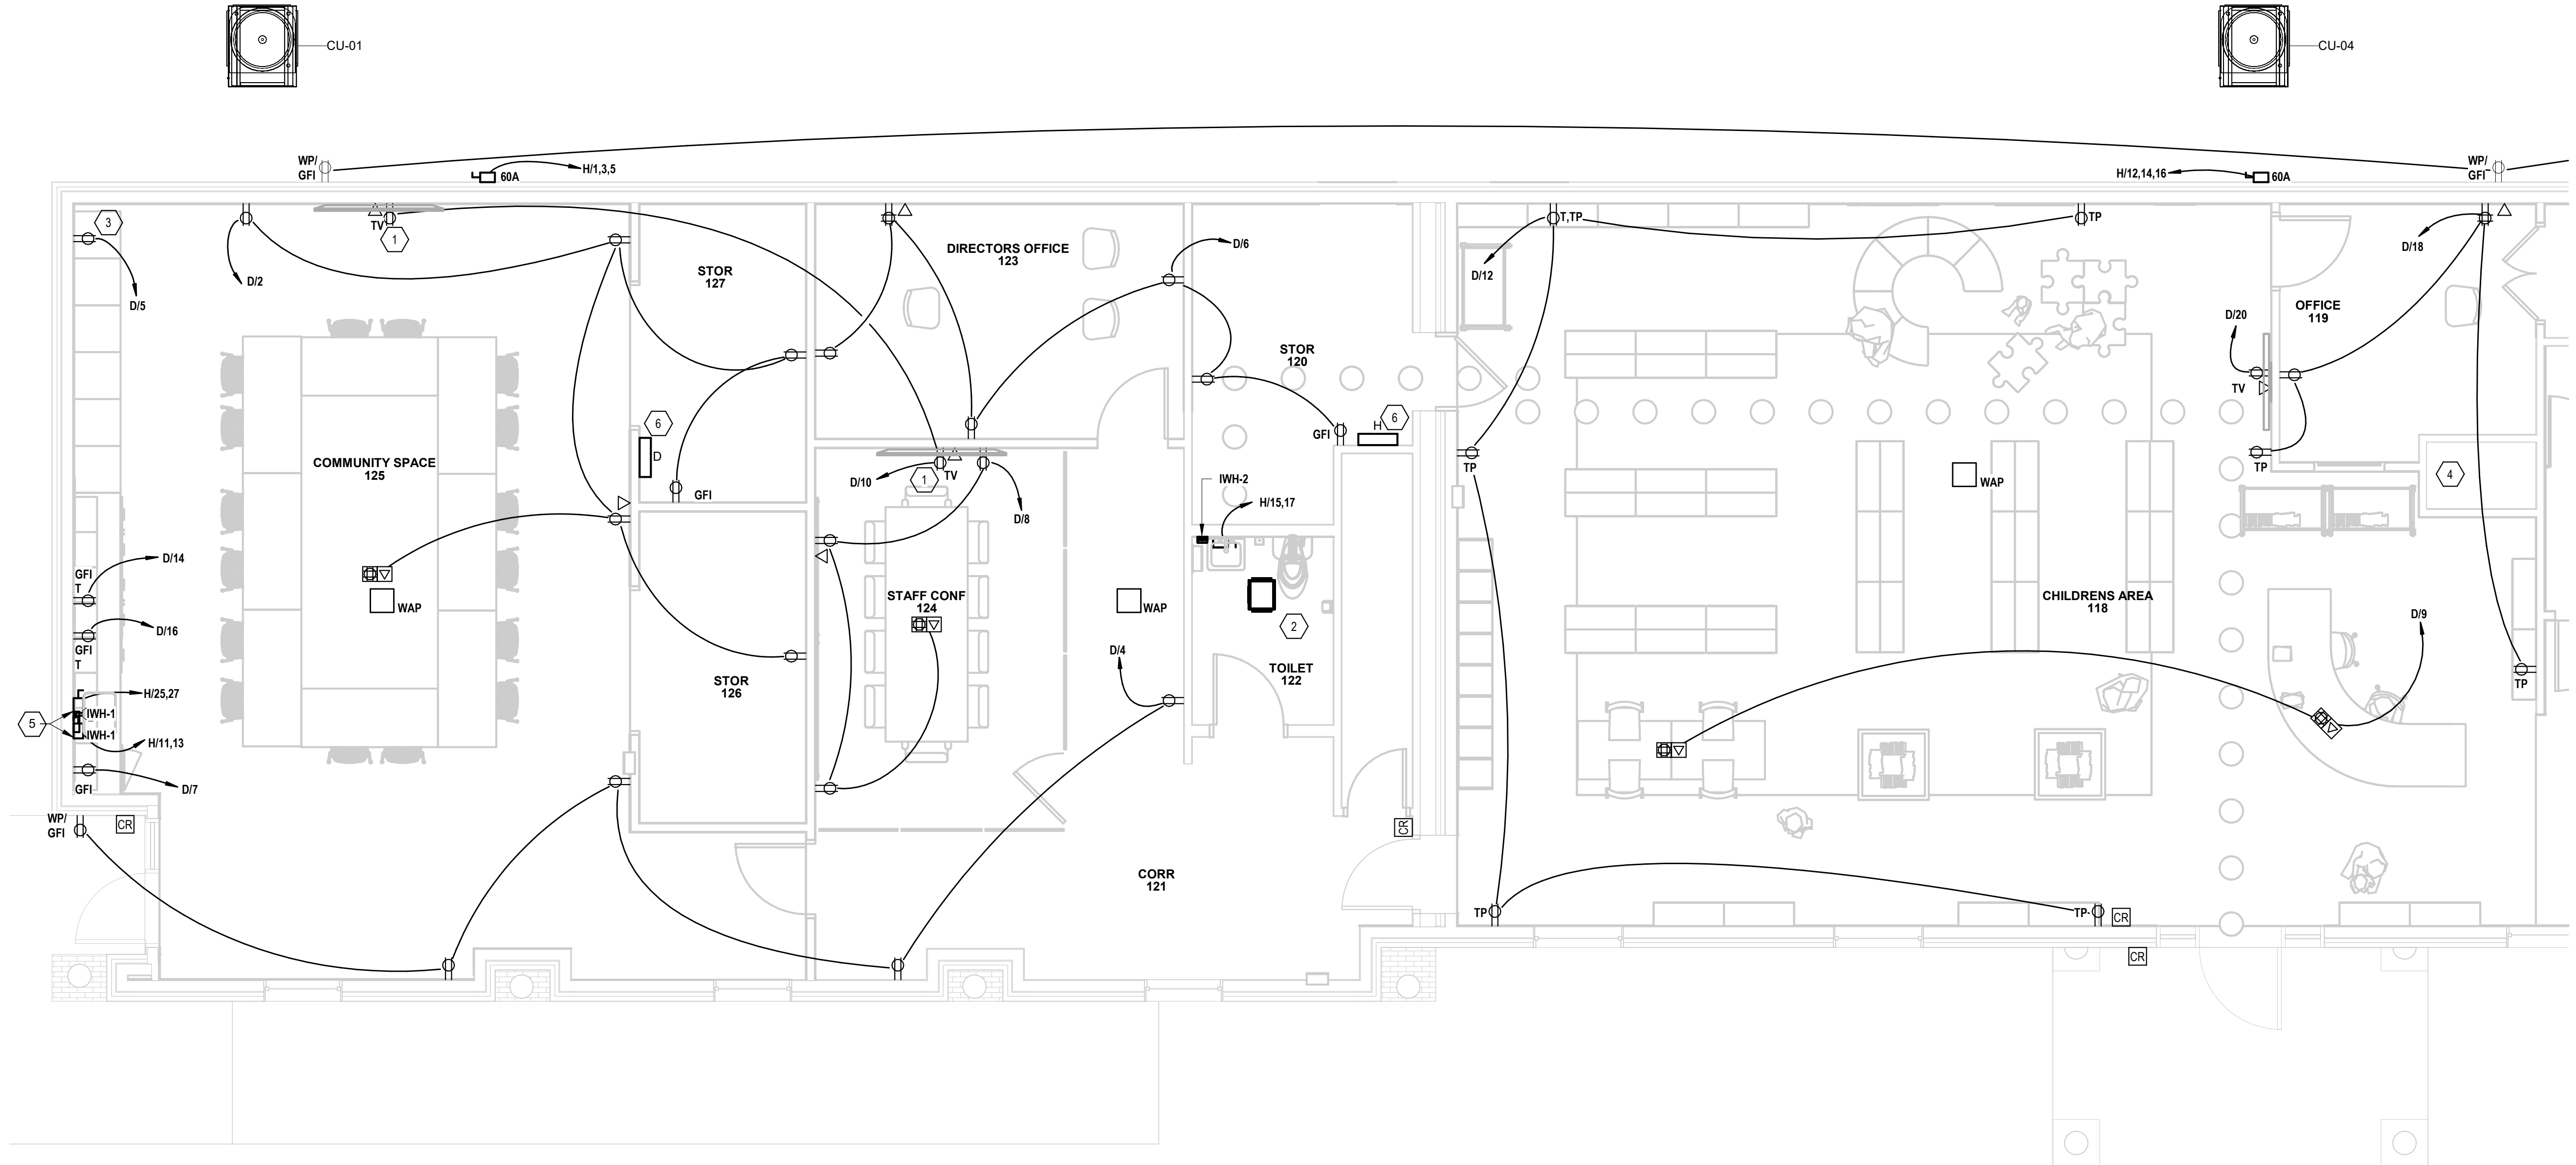

1 FIRST FLOOR POWER PLAN - AREA A - NEW WORK  
E201 SCALE: 1/4" = 1'-0"

KEYED NOTES:


- 1 MOUNT TV POWER AND DATA DEVICES IN RECESSED BOX. COORDINATE MOUNTING HEIGHT WITH ARCHITECTURAL PLANS AND ELEVATIONS.
- 2 TOILET EXHAUST FAN TO BE CONTROLLED WITH THE ROOM LIGHT SWITCH. REFER TO LIGHTING PLANS.
- 3 RECEPTACLE FOR FUTURE SOUND SYSTEM. MOUNT RECEPTACLE IN CABINET. MOUNTING HEIGHT TO BE DETERMINED IN FIELD.
- 4 RECONNECT EXISTING DUMBWAITER TO PANEL H/CIRCUITS 28, 30, 32. REFER TO PANEL SCHEDULES.
- 5 COORDINATE LOCATION OF UNDER-SINK DISCONNECT SWITCHES WITH OTHER EQUIPMENT IN THE SAME AREA.
- 6 EXTEND CIRCUIT FROM DEMOLITION PHASE TO NEW PANEL WITH THE SAME DESIGNATION AS THE DEMO'ED PANEL.

GENERAL NOTES:


A. ALL EXTERIOR DISCONNECT SWITCHES SHALL BE NEMA-3R RATED.

B. ALL EXTERIOR DEVICES SHALL HAVE AN OUTDOOR RATED BOX.

C. ACCESS CONTROL, INTRUSION ALARM AND SECURITY PANELS, DEVICES AND WIRING ARE PROVIDED BY OWNER. PROVIDE INFRASTRUCTURE ONLY FOR THESE DEVICES: BACBOX, CONDUIT AND PULL STRING.

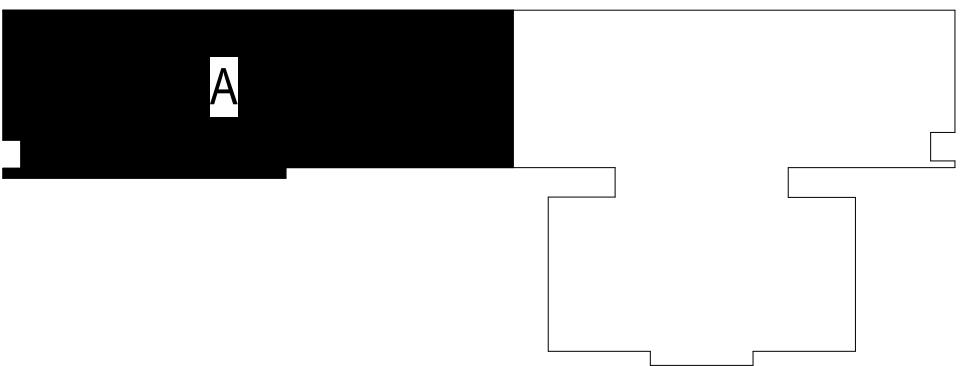

KEYPLAN


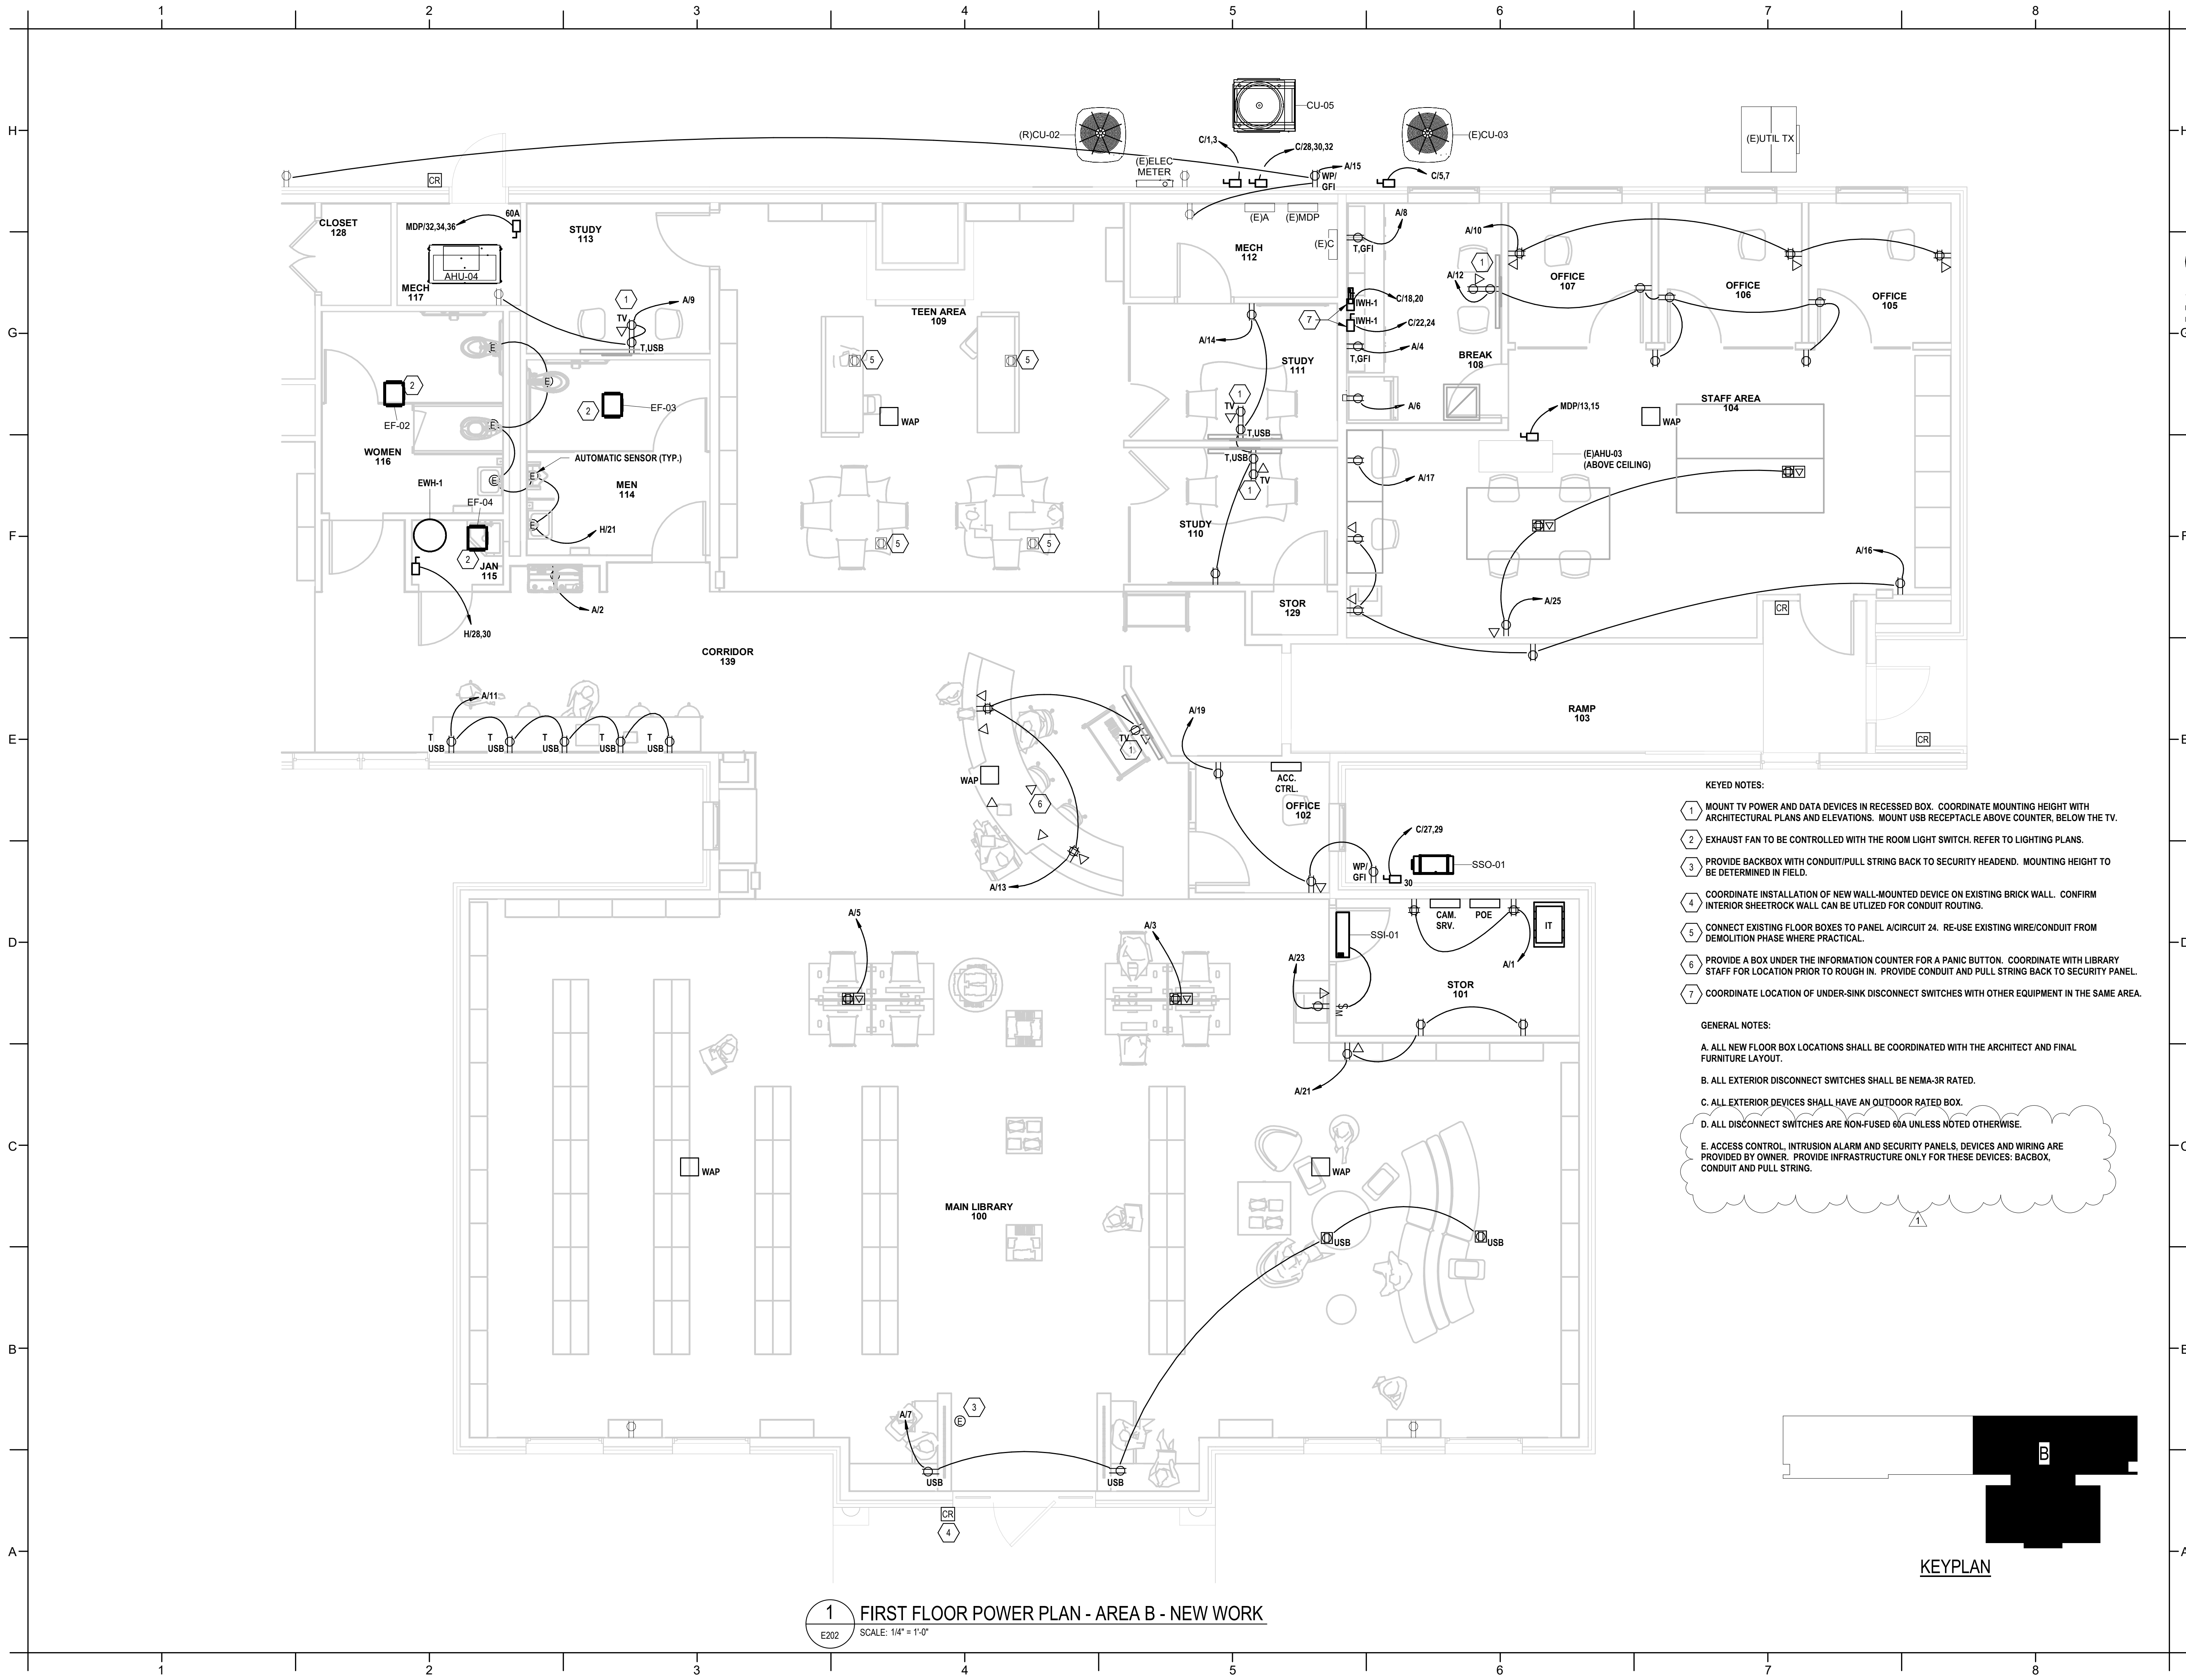


PROJECT INFORMATION

HOCUTT-ELLINGTON  
LIBRARY RENOVATION  
TOWN OF CLAYTON

100 CHURCH ST.  
CLAYTON, NC 27520

SEALS

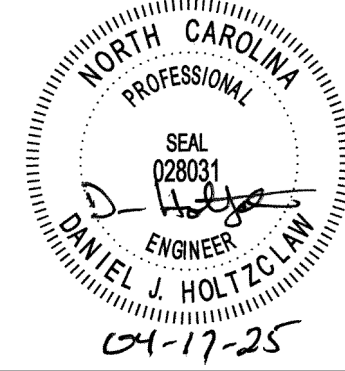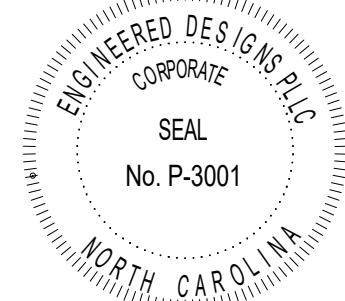

DKA JOB NUMBER  
2415

REVISIONS

| NO. | DESCRIPTION | DATE     |
|-----|-------------|----------|
| 1   | ADD. 2      | 04.17.25 |
|     |             |          |
|     |             |          |
These drawings are the property of Davis Kane Architects, P.A. They may not be reused for any purpose without written permission.  
Copyright © 2024 by Davis Kane Architects, P.A. All rights reserved.

PA: \_\_\_\_\_ JRQ  
PM: \_\_\_\_\_ DJH  
Drawn By: \_\_\_\_\_  
Plot Date: 4/17/2025 8:09:07 AM

DATE ISSUED

BID DOCUMENTS  
03/10/2025

SHEET TITLE  
ELECTRICAL FLOOR  
PLAN - POWER -  
AREA B

E202

KEYED NOTES:

- 1 MOUNT TV POWER AND DATA DEVICES IN RECESSED BOX. COORDINATE MOUNTING HEIGHT WITH ARCHITECTURAL PLANS AND ELEVATIONS. MOUNT USB RECEPTACLE ABOVE COUNTER, BELOW THE TV.
- 2 EXHAUST FAN TO BE CONTROLLED WITH THE ROOM LIGHT SWITCH. REFER TO LIGHTING PLANS.
- 3 PROVIDE BACKBOX WITH CONDUIT/PULL STRING BACK TO SECURITY HEADEND. MOUNTING HEIGHT TO BE DETERMINED IN FIELD.
- 4 COORDINATE INSTALLATION OF NEW WALL-MOUNTED DEVICE ON EXISTING BRICK WALL. CONFIRM INTERIOR SHEETROCK WALL CAN BE UTILIZED FOR CONDUIT ROUTING.
- 5 CONNECT EXISTING FLOOR BOXES TO PANEL A/CIRCUIT 24. RE-USE EXISTING WIRE/CONDUIT FROM DEMOLITION PHASE WHERE PRACTICAL.
- 6 PROVIDE A BOX UNDER THE INFORMATION COUNTER FOR A PANIC BUTTON. COORDINATE WITH LIBRARY STAFF FOR LOCATION PRIOR TO ROUGH IN. PROVIDE CONDUIT AND PULL STRING BACK TO SECURITY PANEL.
- 7 COORDINATE LOCATION OF UNDER-SINK DISCONNECT SWITCHES WITH OTHER EQUIPMENT IN THE SAME AREA.

GENERAL NOTES:

- A. ALL NEW FLOOR BOX LOCATIONS SHALL BE COORDINATED WITH THE ARCHITECT AND FINAL FURNITURE LAYOUT.
- B. ALL EXTERIOR DISCONNECT SWITCHES SHALL BE NEMA-3R RATED.
- C. ALL EXTERIOR DEVICES SHALL HAVE AN OUTDOOR RATED BOX.
- D. ALL DISCONNECT SWITCHES ARE NON-FUSED 80A UNLESS NOTED OTHERWISE.
- E. ACCESS CONTROL, INTRUSION ALARM AND SECURITY PANELS, DEVICES AND WIRING ARE PROVIDED BY OWNER. PROVIDE INFRASTRUCTURE ONLY FOR THESE DEVICES: BACKBOX, CONDUIT AND PULL STRING.

KEYPLAN