

COOPER ACADEMY A & R

PROJECT TITLE
"CLIENT'S PROJECT" # - XXX



1. THIS DRAWING IS THE PROPERTY OF BOOMERANG DESIGN P.A. AND IS NOT TO BE REPRODUCED OR COPIED IN WHOLE OR IN PART. IT IS NOT TO BE USED ON ANY OTHER PROJECT AND IS TO BE RETURNED ON REQUEST.


2. MATERIALS, DIMENSIONS AND ALL OTHER CONDITIONS WHICH ARE NOT OTHERWISE DEFINED ON THIS DRAWING SHALL BE CONTROLLED AS HAVING THE SAME MEANING AS SIMILARLY INDICATED CONDITIONS WHICH ARE MORE FULLY DEFINED ELSEWHERE ON THIS PROJECT OR OTHER DRAWINGS OF THIS PROJECT.

3. DO NOT SCALE OFF DIMENSIONS.

NO.	DATE	DESCRIPTION
1	2/20/24	ADDENDUM #1

BID DOCUMENTS
PROJECT PHASE
2307
BOOMERANG DESIGN PROJECT NUMBER
02.07.24
DRAWING RELEASE DATE

UTILITY PLAN
SHEET TITLE
C501
SHEET

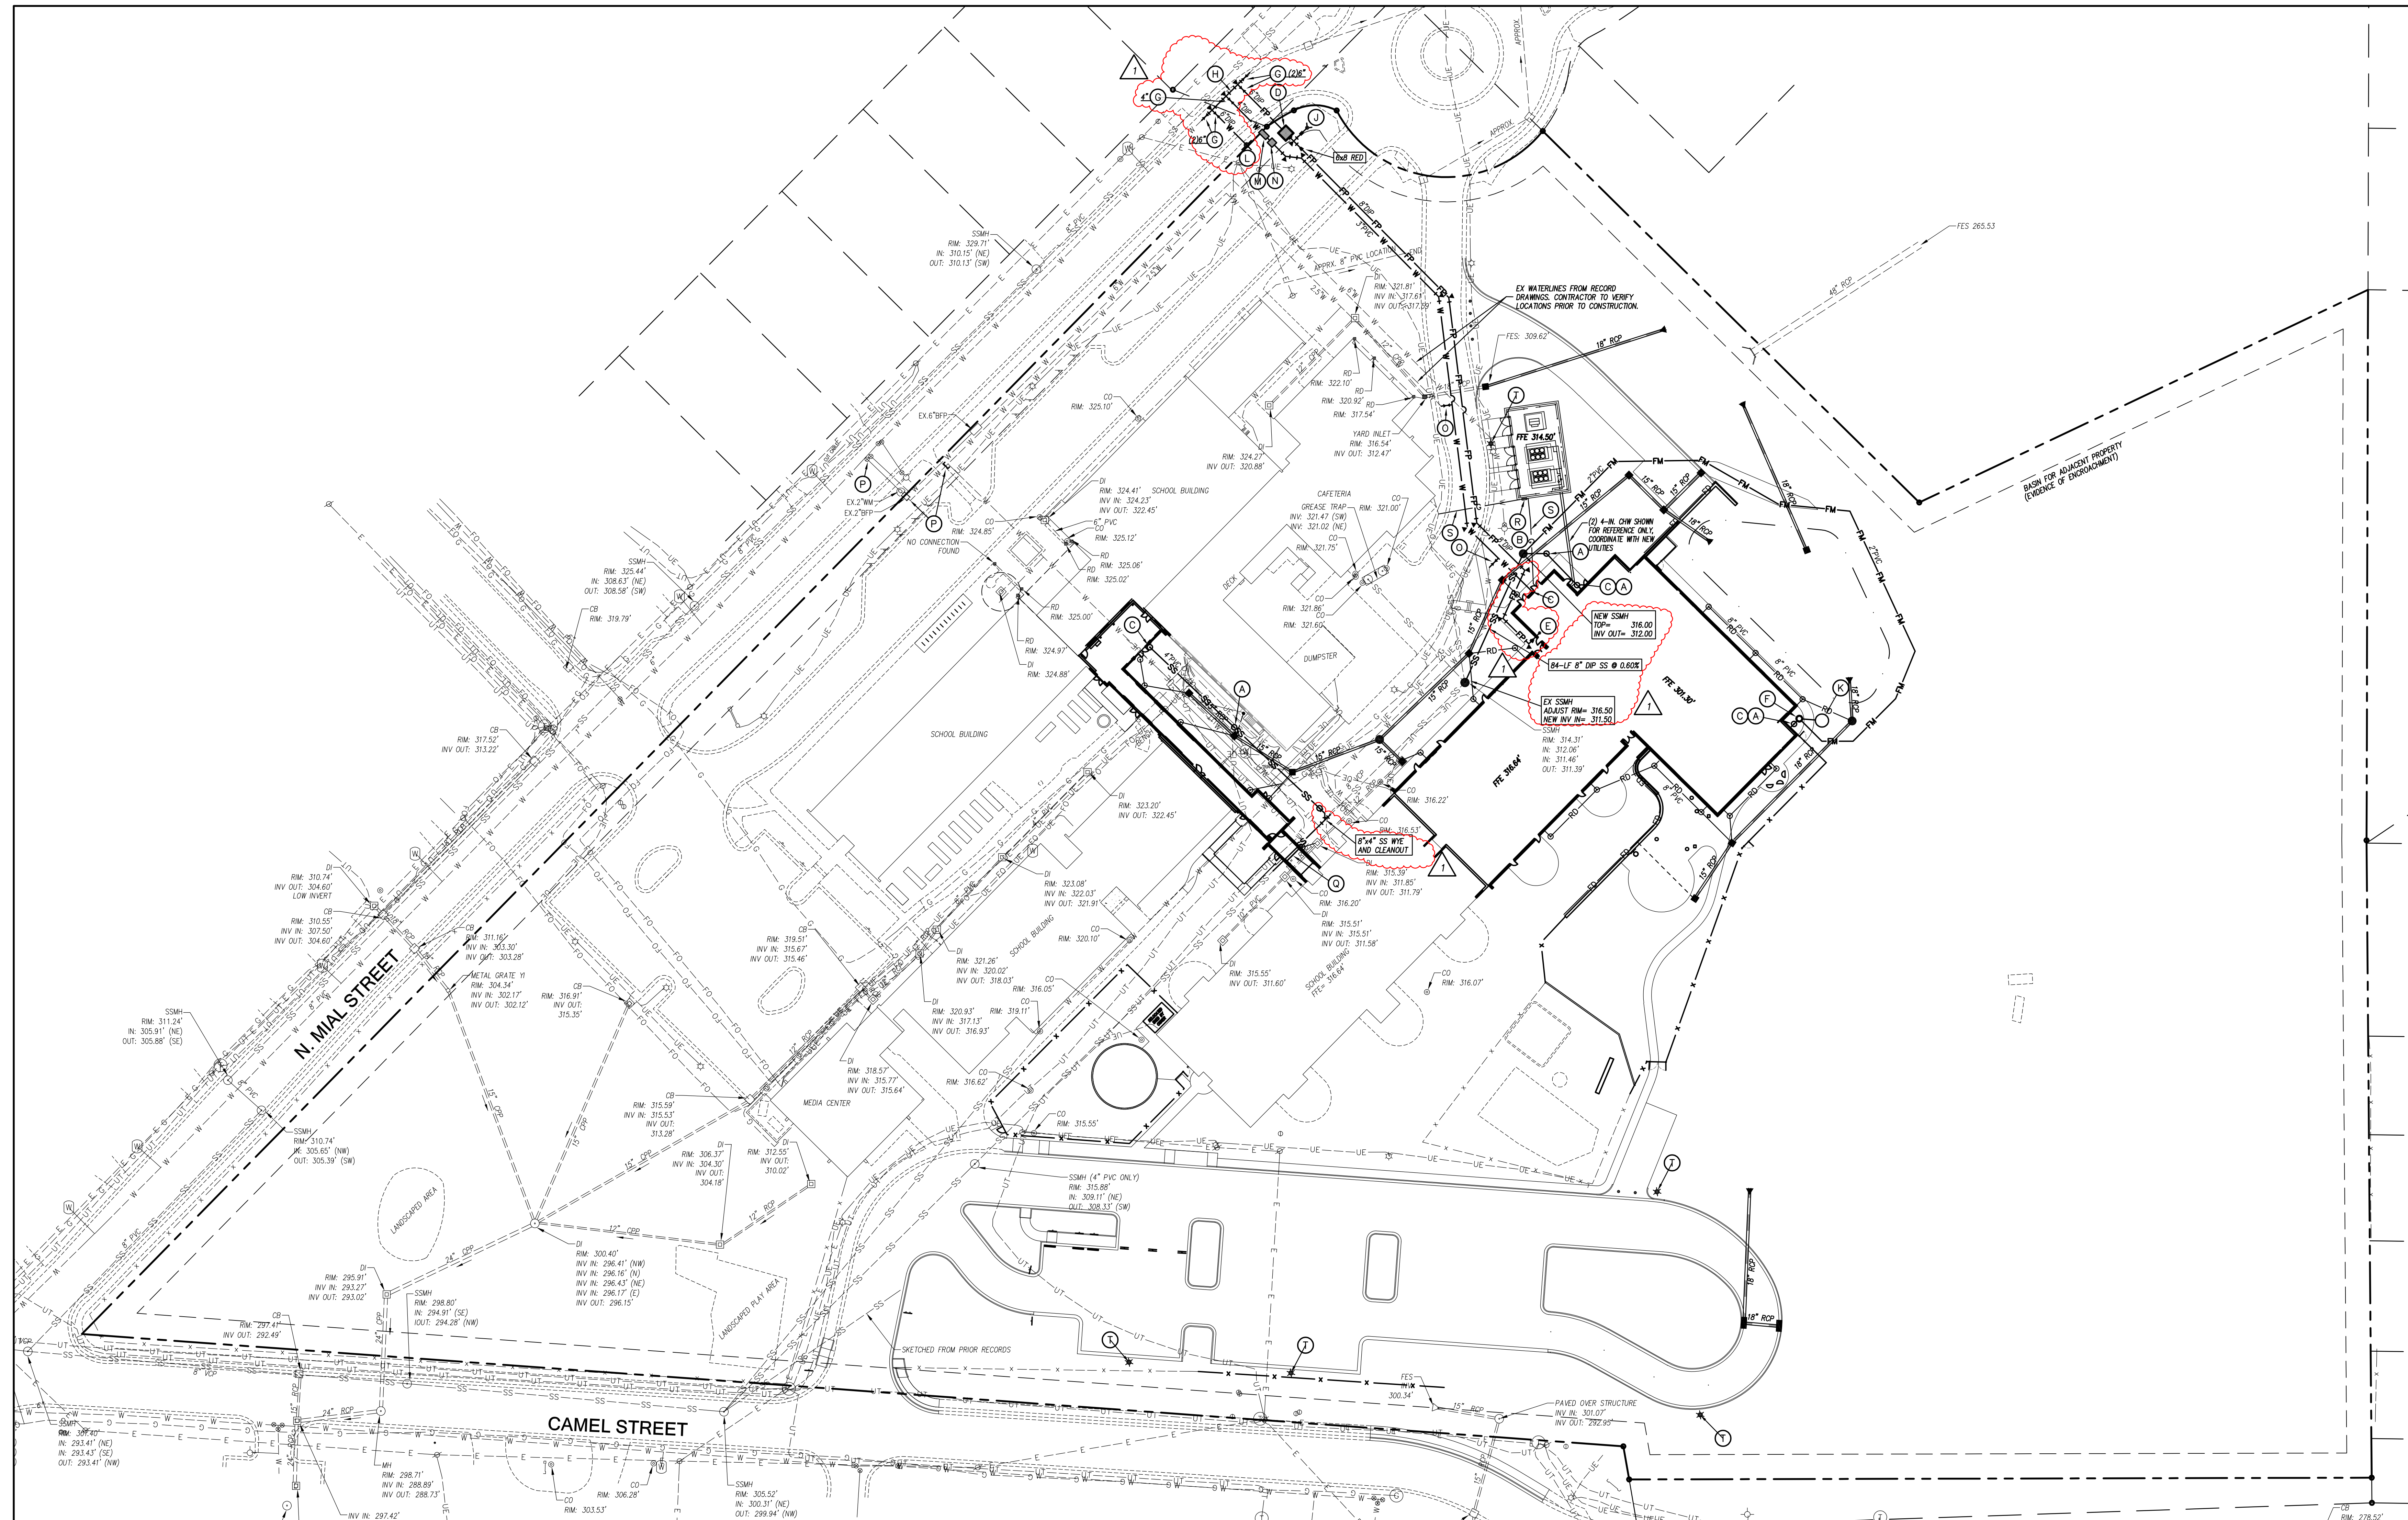

- ### GENERAL NOTES-UTILITY
- ALL CONSTRUCTION SHALL BE IN ACCORDANCE WITH ALL TOWN OF CLAYTON AND NC DOT STANDARDS, SPECIFICATIONS AND DETAILS.
 - INSTALL WATERMANS WITH A COVER OF NO LESS THAN 3'-FT. TO FINISH GRADE IN NON-TRAFFIC AREAS, 4'-FT TO FINISH GRADE IN TRAFFIC AREAS.
 - INSTALL ALL UTILITIES TO PROVIDE REQUIRED CLEARANCES AS INDICATED IN THE SPECIFICATIONS.
 - WATERLINES AND SEWER MAINS SHALL BE INSTALLED WITH A MINIMUM HORIZONTAL CLEARANCE OF 1'-FT.
 - SEWER MAINS SHALL BE INSTALLED WITH A MINIMUM VERTICAL CLEARANCE OF 24-IN TO STORM DRAINAGE PIPES.
 - COORDINATE AND SCHEDULE INSTALLATION OF ALL UTILITIES WITH OTHER PRIME CONTRACTORS, UTILITY COMPANIES AND OTHER TRADES INCLUDING BUT NOT LIMITED TO: NATURAL GAS, ELECTRICITY, TELEPHONE AND CATV.
 - VERIFY EXISTING CONDITIONS AND CONNECTIONS TO EXISTING UTILITIES PRIOR TO CONSTRUCTION. NOTIFY ARCHITECT IF ANY DISCREPANCIES ARE DISCOVERED.
 - CONTRACTOR IS RESPONSIBLE FOR ALL DAMAGES DURING CONSTRUCTION AND SHALL MAKE REPAIRS AT NO EXPENSE TO THE OWNER.
 - ALL CONSTRUCTION SHALL COMPLY WITH ALL APPLICABLE NCSDS AND OSHA REQUIREMENTS.
 - THE CONTRACTOR SHALL PROVIDE AN AS-BUILT SURVEY OF ALL UTILITY AND STORM DRAINAGE IMPROVEMENTS FOLLOWING CONSTRUCTION.
 - CONTRACTOR SHALL PHASE DEMOLITION AND NEW CONSTRUCTION TO ENSURE UNINTERRUPTED ACCESS AND UTILITY SERVICE TO ADJACENT FACILITIES. COORDINATE SHORT-TERM, OFF-HOUR, TEMPORARY SHUT-DOWNS WITH THE OWNER.
 - SEE GENERAL NOTES ON EXISTING CONDITIONS AND DEMOLITION PLAN FOR REQUIREMENTS FOR REMOVAL AND PATCHING OF PAVEMENT FOR UTILITY INSTALLATION.
 - ALL ROOF DRAINS SHALL BE 8" PVC (SCH 40) @ 1/4" MIN. SLOPE UNLESS INDICATED OTHERWISE. USE DUCTILE IRON WHEN COVER IS LESS THAN 24-IN.
 - ALL SANITARY SEWER SERVICES SHALL BE 4" PVC (SCH 40) @ 1/4" MIN. SLOPE UNLESS INDICATED OTHERWISE. USE DUCTILE IRON WHEN COVER IS LESS THAN 24-IN.
 - ALL CONDENSATE LINES SHALL BE CONNECTED TO STORM DRAINAGE SYSTEM.
 - NO WORK SHALL BE PERFORMED ON RIGHT-OF-WAYS OR ADJACENT PROPERTIES UNTIL THE OWNER NOTICES CONTRACTOR IN WRITING OF PROCEDURE OF APPROPRIATE PERMITS, EASEMENTS, AGREEMENTS, OR RIGHTS-OF-WAY.

UTILITY LEGEND

EXISTING	PROPOSED
CHILLED WATER	CHILLED WATER
ELECTRICAL (OVERHEAD)	ELECTRICAL (OVERHEAD)
ELECTRICAL (UNDERGROUND)	ELECTRICAL (UNDERGROUND)
FOUNDATION DRAIN	FOUNDATION DRAIN
GAS	GAS
SANITARY SEWER	SANITARY SEWER
TELEPHONE (OVERHEAD)	TELEPHONE (OVERHEAD)
TELEPHONE (UNDERGROUND)	TELEPHONE (UNDERGROUND)
WATER	WATER
ROOF DRAIN	ROOF DRAIN
FIRE PROTECTION	FIRE PROTECTION
STORM DRAIN	STORM DRAIN
SEE EROSION CONTROL PLANS	SEE EROSION CONTROL PLANS

EXISTING	PROPOSED
LIGHT POLE	LIGHT POLE
UTILITY POLE	UTILITY POLE
MANHOLE	MANHOLE
CATCH BASIN	CATCH BASIN
DROP INLET/CATCH BASIN	DROP INLET/CATCH BASIN
FIRE HYDRANT	FIRE HYDRANT
WATER VALVE	WATER VALVE
POST INDICATOR VALVE (PIV)	POST INDICATOR VALVE (PIV)
FIRE DEPT CONNECTION (FDC)	FIRE DEPT CONNECTION (FDC)
THRUST BLOCKING	THRUST BLOCKING
SANITARY SEWER STRUCTURE ID	SANITARY SEWER STRUCTURE ID

KEY NOTES

- SANITARY SEWER CLEANKUT, TYP. SEE DETAIL SHEET C711.
- SANITARY SEWER MANHOLE, SEE DETAIL SHEET C711.
- EXTEND UTILITY TO WITHIN 5'-0" OF BUILDING WALL OR AS INDICATED ON PLUMBING PLANS. REFER TO PLUMBING PLANS FOR LOCATION AND INVERTS.
- 6-IN REDUCED PRESSURE DETECTOR BACKFLOW ASSEMBLY (RPDA) WITHIN HEATED ENCLOSURE, SEE DETAIL SHEET C710.
- EXTEND WATERLINE TO 12-IN ABOVE FINISH FLOOR FOR FIRE PROTECTION CONNECTION, SEE DETAIL SHEET C710. INSTALL 8" 16" REINFORCED PRIOR TO ENTERING BLDG. REFER TO FIRE PROTECTION PLANS FOR EXACT LOCATION.
- PRIVATE SEWER PUMP STATION, SEE DETAIL SHEET C711.
- GATE VALVE AND VALVE BOX, SEE DETAIL SHEET C709.
- REMOVE AND REPLACE 245'-L.F. OF EX. 6-IN WATERMAIN WITH NEW 6" 16" WATERMAIN, TEE FITTINGS AND VALVES. COORDINATE TEMP. MAIN SHUT-DOWN WITH TOWN OF CLAYTON WATER RESOURCES AND ENGINEERING DEPARTMENT PRIOR TO COMMENCEMENT OF WORK.
- PRECAST SANITARY SEWER STORAGE VAULT, SEE DETAIL SHEET C711.
- FIRE HYDRANT, SEE DETAIL SHEET C710.
- 3-IN DOMESTIC METER IN VAULT.
- 3-IN REDUCED PRESSURE ASSEMBLY WITHIN HEATED ENCLOSURE, SEE DETAIL SHEET C710.
- CONNECT NEW WATER SERVICE TO EXISTING 2.5" WATER SERVICE WITH 3" GATE VALVE.
- REMOVE EX. 2-IN BACKFLOW PREVENTER AND 2-IN METER. DISCONNECT EX. SERVICE LINE AT PUBLIC MAIN AND CAP EX. LINE NEAR SERVICE BRANCH TO EX. BUILDING. SCHEDULE DISCONNECTION FOLLOWING INSTALLATION OF AND CONNECTION OF NEW WATER SERVICE.
- TOWN OF CLAYTON NOTE: ABANDONMENT OF EXISTING SERVICE SHALL BE COORDINATED WITH TOWN OF CLAYTON WATER RESOURCES AND ENGINEERING DEPARTMENT PRIOR TO COMMENCEMENT OF WORK.
- REMOVE AND REPLACE 450'-L.F. OF EX. VCP SS PIPE WITH NEW 8" DIP. PROVIDE 450'-L.F. SECTION OF 16" STEEL ENCASUREMENT WHERE LINE PASSES UNDER BLDG. SEE DETAIL SHEET C711. COORDINATE TEMP. MAIN SHUT-DOWN WITH TOWN OF CLAYTON WATER RESOURCES AND ENGINEERING DEPARTMENT PRIOR TO COMMENCEMENT OF WORK.
- APPROXIMATE LOCATION AND SIZE OF NEW GAS METER. COORDINATE WITH MEP AND LOCAL UTILITY COMPANY.
- APPROXIMATE LOCATION OF LIGHTPOLE. SEE ELECTRICAL DRAWINGS.

